


Section 33 Township 23 Range 35W

Well No. #1 Herbers

Company Stanolind

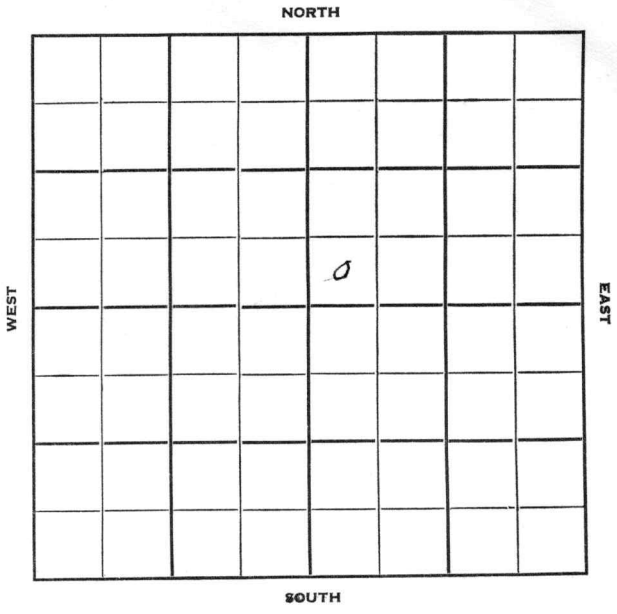

Kearny

KANSAS

Sec. 33 Twp. 23 R. V 35W

Well No. #1 Herbers Farm

Stanolind Company

Contractor

Hugoton Pool


\_\_\_\_\_ Ft. from N. Line

150' Ft. from S. Line

\_\_\_\_\_ Ft. from E. Line

150' Ft. from W. Line

SW NE

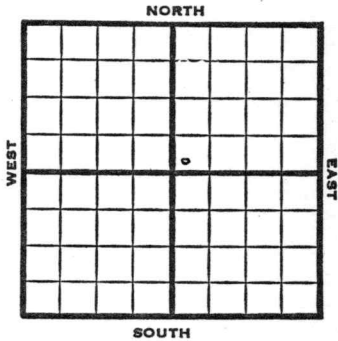

1951

Elev. 3019'

REPORT

4/11  
5/16

Location

Gas Well TD 2747

10" @ 939

Her. 2533 Win 2591

Ft. Riley 2653

TD 2747 6" @ 2715

42/2653-60 144/2666-90 72/2592-2604

30/2615-20 72/2622-34 78/2543-56

60/2578-88 12,500 A PB 2702

8000 A Comp. 9,300,000 gas

**COMPLETED**

County Kearny State Kansas

Sec. 33 (Blk. 1 Twp.) 23 (Sur. Rge.) 35W Map No.

Operator Stanolind

Well No. 1 Farm Herbers

Elev. \_\_\_\_\_ Location SW NE

			0		

150 Ft. From S Line NE

150 Ft. From W Line Quarter

1st. Report APR 11 1951

Completion \_\_\_\_\_

Remarks \_\_\_\_\_

Spudding Date \_\_\_\_\_

Drlg. Data Hugoton Pool

Location

J. E. TYRA

