


Map No. KANSAS Sec. 34 Twp. 23 R. 4th

Well No. 1-Boughman Farm
Barnsdall & 1710 Company

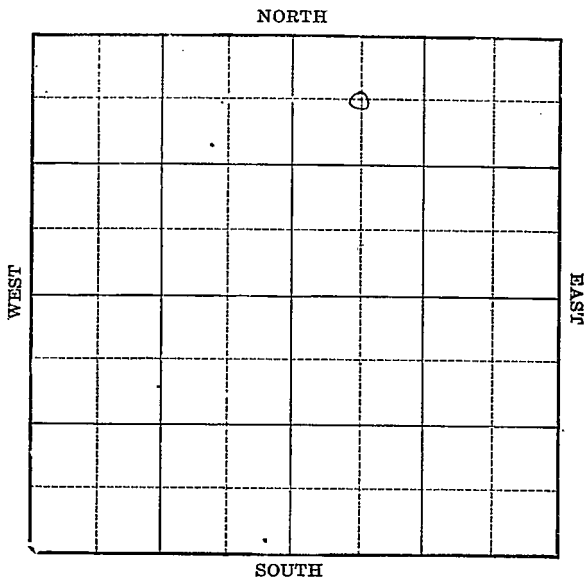

Location _____

Drilling Remarks _____

Rig Up _____

Drilling Remarks _____

RECORD

Cased _____ in. _____ ft.

Sand _____

Gas _____

Oil _____

Total Depth _____

PRODUCTION

1st 24 hrs. Nat. _____

1st 24 hrs. after shot _____

Gas _____ cu. ft.

Dry Hole _____

Abandoned _____

Map No. **KANSAS** Sec. 34 Twp. 23 R. 4^W

Well No. 1-Boughman Farm
Barnsdall & 1740 Company


660 Ft. from N. Line

_____ Ft. from S. Line

_____ Ft. from E. Line

660 Ft. from W. Line

19.32

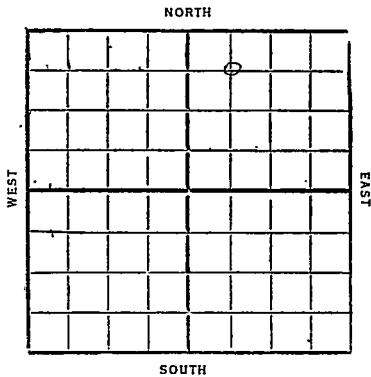

Date	REPORT
7/13	Bldg rotary rig
7/20	Cem 15"-243
7/27	Cem 12"-495
	TD 610'
	12" parted
8/3	Drlg 1923
8/10	" 2840'
8/17	Top chat 3280
	Cem 8"-3285
	SD 3292'
8/24	At 3327
	Est 3 to 4 Mc gas
	No oil
	Drlg 3352
8/31	Crom 3369 3369
	Made 84 bbl oil and
	84 bbl water and
	6 Mc gas
	Deezened to
	TD 3390 To test
	(over)

9/17- TD 3390
flow 60 bbl oil and
60 bbl water 24 hr

9/14- Cased 8"-3285
Chat 3280-3390
TD 3390
flow 45 bbl oil and
120 bbl water 24 hr
32° grav
13 M gas
Comp

Beno

40 KANSAS

Map No. _____ Sec. *34* Twp. *73* R. *4* W

Well No. *1* *Baughman*

Barnsdall Oil & IT 1 Co Company

Contractor _____

FIRST REPORTS

SECTION PLAT

660 Ft. from N. Line
 _____ Ft. from S. Line
 _____ Ft. from E. Line
660 Ft. from W. Line

		o	

Location _____

Rig up _____

Drilling and Remarks:

Blog Rotary Rig

RECORD

Cased _____ in., _____ ft.
 Sand _____
 Gas _____
 Oil _____
 Total Depth _____

PRODUCTION

1st 24 hrs. Nat. _____
 1st 24 hrs. after shot _____
 Gas _____ Cu. Ft.
 Dry Hole _____
 Abandoned _____

Date

JUL 1 3 1932 **CHAS. L. SHERWOOD**
 _____ 192 _____ Scout

Reno

W

40 KANSAS Map No. Sec. 34 Twp. 23 R. 4

Well No. 1 Baughman
Barnsdall & T J Oil Co Company

Contractor

COMPLETED

SECTION PLAT

		0	
			.
.			
		.	

660 Ft. from N. Line
..... Ft. from S. Line
..... Ft. from E. Line
660 Ft. from W. Line

Location.....

Rig up.....

Drilling and Remarks:

Flow 45 Bls Oil
180 Bls Water
in 24 hours.

38 Gravity

RECORD

Cased 28 in., 3285 ft.
Sand hat 3280-3390
Gas.....
Oil.....
Total Depth 3390

PRODUCTION

1st 24 hrs. Nat.....
1st 24 hrs. after shot.....
Gas 1.3 M Cu. Ft.
Dry Hole.....
Abandoned.....

Date

SEP 1 4 1932

192

CHAS. L. SHERWOOD

Scout