


Reno

Map No. KANSAS Sec. 34 Twp. 23 R. 4^W

Well No. 2 Baughman Farm
Barnsdall & ITIO Company

990 Ft. from N. Line
____ Ft. from S. Line
330 Ft. from E. Line
____ Ft. from W. Line

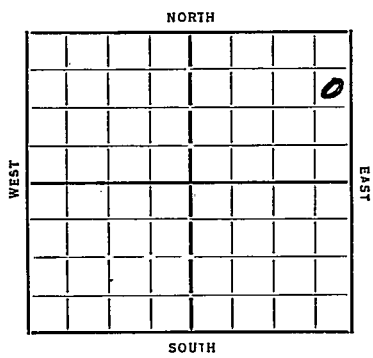

Date 1954 REPORT

9/26 *Bldg.*
10/4 *Rig*
10/11 *Dlg 827 15 1/2 133 12 1/2 503*
10/18 *" 2890*
10/25 *" 3431 Chat 3232*
10/21 *Hutton 3579 TD 3585 1/2*
3042 Bldg 24 hrs.

COMPLETED

Map No. 40 Sec. 34 Twp. 23 R. 4W

Well No. 2 - Baughman

Barnsdall & ITI Company

Contractor

SECTION PLAT

				o

990 Ft. from N. Line

_____ Ft. from S. Line

330 Ft. from E. Line

_____ Ft. from W. Line

FIRST REPORTS.

Location _____

Rig up _____

Drilling and Remarks:

Bldg

RECORD

Cased _____ in., _____ ft.

Sand _____

Gas _____

Oil _____

Total Depth _____

PRODUCTION

1st 24 hrs. Nat. _____

1st 24 hrs. after shot _____

Gas _____ Cu. Ft.

Dry Hole _____

Abandoned _____

Date

9-26-34₁₉

ORVAL MANNSCHER Scout

Map No. 40 Sec. 34 Twp. 23 R. 4W

Well No. 2 - Baughman

Barnsdall + Itie Company

Contractor

~~COMPLETED~~

SECTION PLAT

			0

990 Ft. from N. Line

_____ Ft. from S. Line

330 Ft. from E. Line

_____ Ft. from W. Line

Location _____

Rig up _____

Drilling and Remarks:

3042 bbls
24 hrs

RECORD

Cased _____ in., _____ ft.

Sand Hutton 3579

Gas _____

Oil _____

Total Depth 3585 1/2

PRODUCTION

1st 24 hrs. Nat. _____

1st 24 hrs. after shot _____

Gas _____ Cu. Ft.

Dry Hole _____

Abandoned _____

Date

10-31-34 19

ORVAL MANNSCHECK

Scout