


Map No. KANSAS Sec. 34 Twp. 23 R. 4W
 Well No. #2 H. Baughman Farm
Barnsdall Oil Company

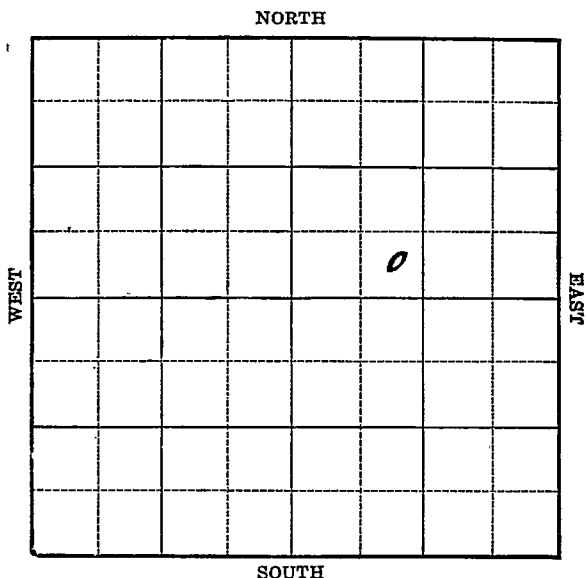

Location _____
 Drilling Remarks _____

Rig Up _____
 Drilling Remarks _____

RECORD

Cased _____ in. _____ ft.
 Sand _____
 Gas _____
 Oil _____
 Total Depth _____

PRODUCTION

1st 24 hrs. Nat. _____
 1st 24 hrs. after shot _____
 Gas _____ cu. ft.
 Dry Hole _____
 Abandoned _____

_____ Ft. from N. Line

330 _____ Ft. from S. Line

_____ Ft. from E. Line

990 _____ Ft. from W. Line

					NORTH					
					SOUTH					

Date /

REPORT

1/4/33
 2/1/3 Location
 2/2/1 Rig
 2/2/8 dly 455 16" 206
 3/7 dly 590
 3/14 12" 649 dly 1200
 3/21 dly 2895
 3/28 " 3484 Chat 3251
 4/4 Hutton 3608 7" 3606
 3610-12 1 1/2 Barrels oil &
 1 W P/H 1000 acid
 4/11 3690 T7 PB to Chat
 4/18 PB 3578
 4/26 P 209 Bbls 13 1/2 hrs
 No Water
 5/1 Hutton 3608 T7 3690
 PB 3578 303 oil 30 W.

COMPLETED

Map No. 40 Sec. 34 Twp. 23 R. 4WWell No. 2-H. BaughmanBarnsdall oil

Company

Contractor

FIRST REPORTS

SECTION PLAT

Ft. from N. Line

330 Ft. from S. Line

Ft. from E. Line

990 Ft. from W. Line

KANSAS

		o	

Location ✓

Rig up

Drilling and Remarks:

RECORD

Cased in., ft.Sand Gas Oil Total Depth

PRODUCTION

1st 24 hrs. Nat. 1st 24 hrs. after shot Gas Cu. Ft.Dry Hole Abandoned

Date

ORVAL MANNSCHRECK

2-13-35 192

Scout

Map No. 40 Sec. 34 Twp. 23 R. 4WWell No. 2-H. BaughmanBarnsdall Company

Contractor

COMPLETED

SECTION PLAT

Ft. from N. Line

330 Ft. from S. Line

Ft. from E. Line

990 Ft. from W. Line

		0	

Location

Rig up

Drilling and Remarks:

PB 3578303 oil30 W

RECORD

Cased in. ft.Sand Hutton 3608

Gas

Oil

Total Depth 3690

PRODUCTION

1st 24 hrs. Nat.

1st 24 hrs. after shot

Gas Cu. Ft.

Dry Hole

Abandoned

Date

ORVAL MANNING

5-1-35 192

Scout