




*Reno*

Map No. NSA Sec. 34 Twp. 23 R. 40

Well No. # 2 England Farm  
Olsen & Shell Company

330 Ft. from N. Line  
\_\_\_\_ Ft. from S. Line  
\_\_\_\_ Ft. from E. Line  
990 Ft. from W. Line

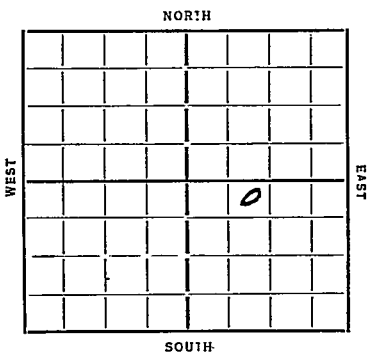

Date  
1/9  
1/17  
1/31  
2/7  
2/14  
2/21  
2/28  
3/7  
3/14  
3/21  
3/28  
4/3

REPORT

Location  
1/24  
Ponds  
Rig  
Wlg 260  
1804 15" 260  
" 2973  
" 3455  
Chst 3257 7" 3595 Rust  
Wentow 3596 T 7 3604  
Shock 78 Bbls 8 hrs thru Tubg  
Wentow 3596 T 7 3604  
2000 acid 7353 Bbls.

COMPLETED

Map No. 40 Sec. 34 Twp. 23 R. 4W

Well No. 2-England

Olsen & Shell Company

Contractor

**FIRST REPORTS**

330 Ft. from N. Line

..... Ft. from S. Line

..... Ft. from E. Line

990 Ft. from W. Line

**SECTION PLAT**

		0	

Location

Rig up.....

Drilling and Remarks:

**RECORD**

Cased.....in., .....ft.

Sand.....

Gas.....

Oil.....

Total Depth.....

**PRODUCTION**

1st 24 hrs. Nat.....

1st 24 hrs. after shot.....

Gas.....Cu. Ft.

Dry Hole.....

Abandoned.....

Date

1-9-35 192.....

**ORVAL MANSCHRECK**

Scout

APR 1935

Map No. 20 Sec. 34 Twp. 23 R. 4W

Well No. 2-England

Olsen & Shell Company

Contractor

**COMPLETED**

SECTION PLAT

330 Ft. from N. Line

..... Ft. from S. Line

..... Ft. from E. Line

990 Ft. from W. Line

		0	

Location.....

Rig up.....

Drilling and Remarks:

2000 sid

2353 bbl

RECORD

Cased..... in..... ft.

Sand Hutton 3596

Gas.....

Oil.....

Total Depth 3604

PRODUCTION

1st 24 hrs. Nat.....

1st 24 hrs. after shot.....

Gas..... Cu. Ft.

Dry Hole.....

Abandoned.....

Date

4-3-35 192

**ORVAL MANNSCHRECK**

Scout