

KANSAS

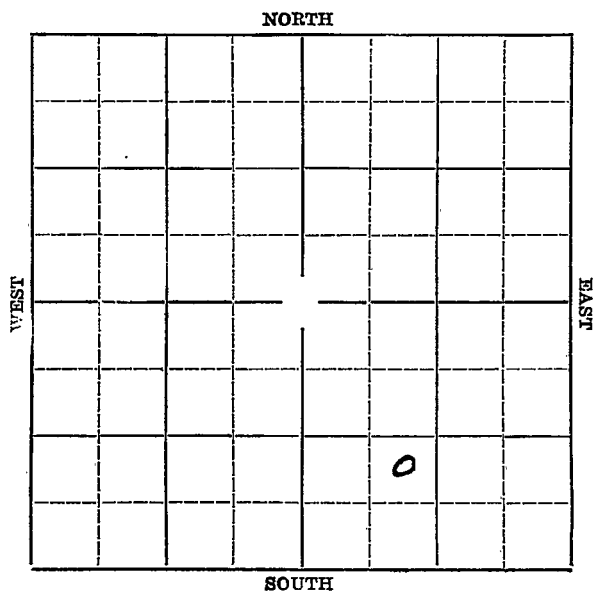
Reno

Form 51-5M-4-36-Palace

Section 34 Township 23 Range 4-W

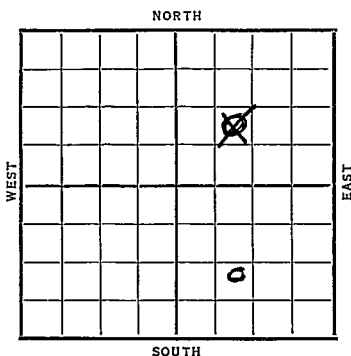
Well Number #6-England

Company Olson & Shell



KANSAS

Reno

Sec. 34 Twp. 23 R. 4WWell No. #6 England FarmOlson & Shell Company Ft. from N. Line990' Ft. from S. Line Ft. from E. Line990' Ft. from W. Line~~1936~~

REPORT

9/23 Cellar.

10/1 Building rig.

10/8 12" @ 243'. Waiting on cement.

10/15 Drlg. 2060'.

10/22 Drlg. 2925'.

10/29 Chat 3256'. 7" @ 3323'. Drlg.

11/6 T. D. 3375

11/10 Chat 3256 T. D. 3375

Pot. 40 oil show water

COMPLETED

KANSAS

Map No. 40 Sec. 34 Twp. 23 R. 4W.Well No. 6 EnglandOlson & Shell Company

Contractor

SECTION PLAT

 Ft. from N. Line990 Ft. from S. Line Ft. from E. Line990 Ft. from W. Line

FIRST REPORT

Location Rig up

Drilling and Remarks:

Cellar

RECORD

Cased in., ft.Sand Gas Oil Total Depth

PRODUCTION

1st 24 hrs. Nat. 1st 24 hrs. after shot Gas Cu. Ft.Dry Hole Abandoned

Date

SEP 23 1936

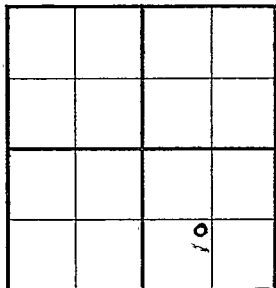
S. J. LEWIS Scout

KANSAS

Map No. 40 Sec. 34 Twp. 23 R. 4W.Well No. 6 Eng lamsOlson & Shell Company

Contractor

SECTION PLAT

 Ft. from N. Line990 Ft. from S. Line Ft. from E. Line990 Ft. from W. Line

COMPLETED

Location Rig up

Drilling and Remarks:

Chat 3256Prod 40 oil
show water

RECORD

Cased in., ft.Sand Gas Oil Total Depth 3375

PRODUCTION

1st 24 hrs. Nat. 1st 24 hrs. after shot Gas Cu. Ft.Dry Hole Abandoned

Date

NOV 10 1936 19

S. J. LEWIS

Scout