


*Reno*

Map No. \_\_\_\_\_ Sec. *34* Twp. *23* R. *4W*

Well No. *#1 Grandon* Farm \_\_\_\_\_  
*Tidewater Oil* Company

NORTH

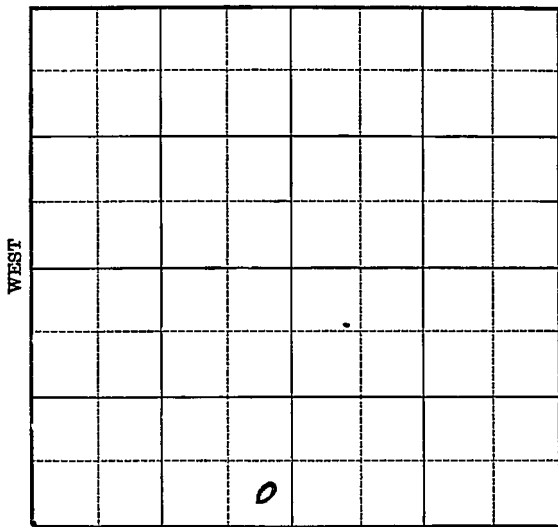

SOUTH

Location \_\_\_\_\_

Drilling Remarks \_\_\_\_\_

Rig Up \_\_\_\_\_

Drilling Remarks \_\_\_\_\_

**RECORD**

Cased \_\_\_\_\_ in. \_\_\_\_\_ ft.

Sand \_\_\_\_\_

Gas \_\_\_\_\_

Oil \_\_\_\_\_

Total Depth \_\_\_\_\_

**PRODUCTION**

1st 24 hrs. Nat. \_\_\_\_\_

1st 24 hrs. after shot \_\_\_\_\_

Gas \_\_\_\_\_ cu. ft.

Dry Hole \_\_\_\_\_


Abandoned \_\_\_\_\_

*Reno*


Well No. 1 Brandon Farm  
Tidewater Oil Company

\_\_\_\_\_ Ft. from N. Line  
330 Ft. from S. Line  
330 Ft. from E. Line  
\_\_\_\_\_ Ft. from W. Line

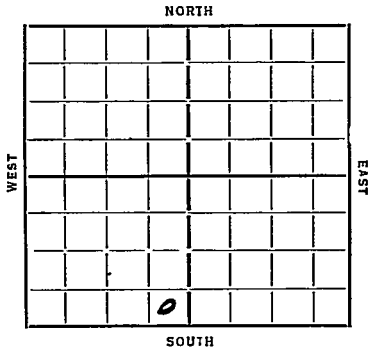

Date	REPORT
<u>7/23</u>	<u>Moving in</u>
<u>1/23</u>	<u>Rig Rot</u>
<u>2/7</u>	<u>DL 1183 15 1/2 250</u>
<u>2/14</u>	<u>" 2583</u>
<u>2/21</u>	<u>" 3045</u>
<u>2/28</u>	<u>" 3453 Chat 3260</u>
<u>3/7</u>	<u>BL 3503 Henton 3593</u>
	<u>TJ 3603 Run 898</u>
<u>3/14</u>	<u>Drilling</u>
<u>3/21</u>	<u>—</u>
<u>3/27</u>	<u>Henton 3593 TJ 3603</u>
	<u>1053 Bble.</u>

COMPLETED

Map No. 40 Sec. 34 Twp. 23 R. 4W

Well No. 1-Manson

Tidewater Oil Company

Contractor

**FIRST REPORTS SECTION PLAT**

.....Ft. from N. Line

330 Ft. from S. Line

330 Ft. from E. Line

.....Ft. from W. Line


Location.....

Rig up.....

Drilling and Remarks:

*Moving in*

**RECORD**

Cased.....in., .....ft.

Sand.....

Gas.....

Oil.....

Total Depth.....

**PRODUCTION**

1st 24 hrs. Nat.....

1st 24 hrs. after shot.....

Gas.....Cu. Ft.

Dry Hole.....

Abandoned.....

Date

1-23-35 192.....

**ORVAL MANN SCHRECK**

Scout

*Reno*  
 Map No. 40 Sec. 34 Twp 23 R. 4W

Well No. 1-Grandon

Tidewater Oil Company

Contractor

**COMPLETED**

**SECTION PLAT**

.....Ft. from N. Line

330 Ft. from S. Line

330 Ft. from E. Line

.....Ft. from W. Line


Location.....

Rig up.....

Drilling and Remarks:

*1053 lbs*

**RECORD**

Cased.....in.,.....ft.

Sand Hunton 3593

Gas.....

Oil.....

Total Depth 3603

**PRODUCTION**

1st 24 hrs. Nat.....

1st 24 hrs. after shot.....

Gas.....Cu. Ft.

Dry Hole.....

Abandoned.....

Date

3-27-35 192

**ORVAL MANNSCHECK**

Scout