


Reno


Well No. #2 Grandon Farm _____

Tidewater Oil Company _____

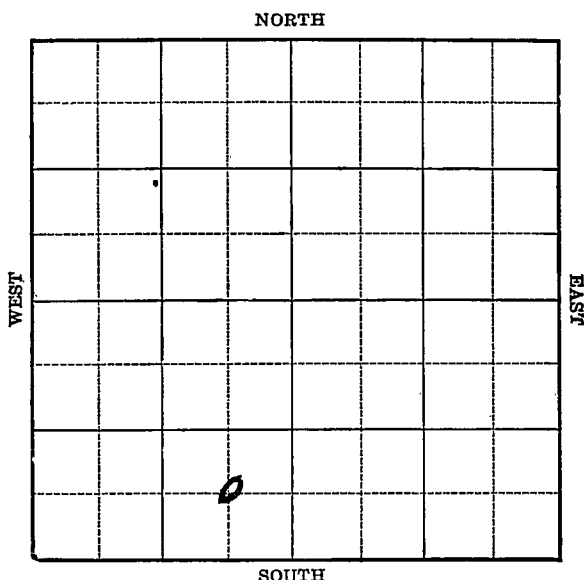

Location _____

Drilling Remarks _____

Rig Up _____

Drilling Remarks _____

RECORD

Cased _____ in. _____ ft.

Sand _____

Gas _____

Oil _____

Total Depth _____

PRODUCTION

1st 24 hrs. Nat. _____

1st 24 hrs. after shot _____

Gas _____ cu. ft.

Dry Hole _____

Abandoned _____

Reno


Map No. KANSAS Sec. 34 Twp. 23 R. 4^W
Well No. #2 ~~3~~ Grandon Farm
Tidewater Oil Company

 Ft. from N. Line

660 Ft. from S. Line

660 Ft. from E. Line

 Ft. from W. Line

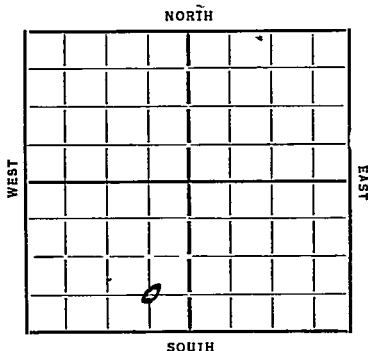

Date

REPORT

1/23	Location
1/31	2/7 — 2/14 — 2/21 —
2/28	3/7 — 3/14 — 3/21 —
3/28	4/4 —
4/11	MJ Rotary
4/18	15 1/2 256 WOC
4/24	Alg 1210 12 1/2 590
5/2	" 2735
5/9	TC 3261 8" 3275
5/16	Alg 3288
5/23	
5/29	Est 80 Bbls oil 5 M Gas
6/5	Chat 3261 T 7 3358
	545 oil 10 Water

COMPLETED

Reno
 Map No. 40 Sec. 34 Twp. 23 R. 4N
 Well No. 3-Granlon
Tidewater Oil Company

Contractor

FIRST REPORTS SECTION PLAT

.....Ft. from N. Line
660 Ft. from S. Line
660 Ft. from E. Line
Ft. from W. Line

Location ☒
 Rig up.....
 Drilling and Remarks:

RECORD

Cased.....in.,ft.
 Sand.....
 Gas.....
 Oil.....
 Total Depth.....

PRODUCTION

1st 24 hrs. Nat.....
 1st 24 hrs. after shot.....
 Gas.....Cu. Ft.
 Dry Hole.....
 Abandoned.....

Date

ORVAL MANNSCHRECK

1-23-35 192.....Scout

Map No. 40 Sec. 34 Twp. 23 R. 4^wWell No. 2-Brandon
Tidewater Oil Company

Contractor

CORRECTION

Ft. from N. Line

660 Ft. from S. Line660 Ft. from E. Line

Ft. from W. Line

SECTION PLAT

	0		

Location.....

Rig up.....

Drilling and Remarks:

*formerly
reported as
3*

RECORD

Cased.....in.,ft.

Sand.....

Gas.....

Oil.....

Total Depth.....

PRODUCTION

1st 24 hrs. Nat.....

1st 24 hrs. after shot.....

Gas.....Cu. Ft.

Dry Hole.....

Abandoned.....

Date

5-1-35 192ORVAL MANNSCHECK
Scout

Map No. 40 Sec. 34 Twp. 23 R. 4 WWell No. 2-Brandon
Tidewater Company

Contractor

SECTION PLAT

	0		

Ft. from N. Line

660

Ft. from S. Line

660

Ft. from E. Line

Ft. from W. Line

RECORD

Location

Cased _____ in. _____ ft.

Rig up

Sand Chat 3261

Drilling and Remarks:

Gas _____

Oil _____

Total Depth 3358545 oil
10 water

PRODUCTION

1st 24 hrs. Nat. _____

1st 24 hrs. after shot _____

Gas _____ Cu. Ft.

Dry Hole _____

Abandoned _____

Date

6-5-35

192

7/6: MANNECH-REC

Scout