


Reno

Form 51-5M-11-31-Palace

Map No. **KANSAS** Sec. 34 Twp. 23 R. 4W

Well No. 1 Mc Elvain Farm

Deal Oil & Gas Company

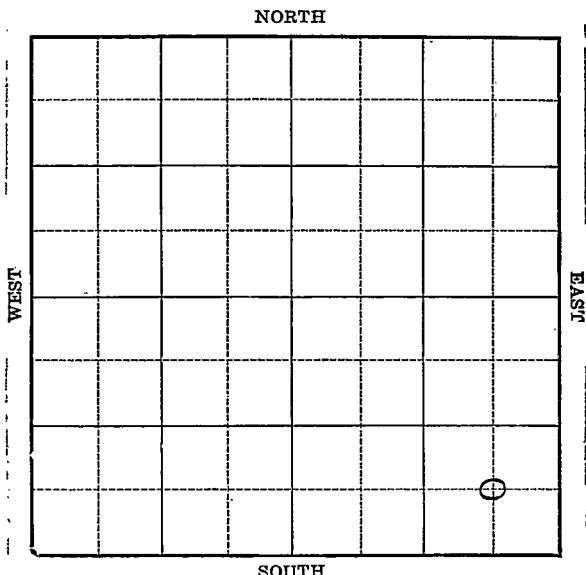

Location _____

Drilling Remarks _____

RECORD

Cased _____ in. _____ ft.

Sand _____

Gas _____

Oil _____

Total Depth _____

Rig Up _____

Drilling Remarks _____

PRODUCTION

1st 24 hrs. Nat. _____

1st 24 hrs. after shot _____

Gas _____ cu. ft.

Dry Hole _____

Abandoned _____

Reno

Map No. KANSAS Sec. 34 Twp. 23 R. 4W


Well No. 1 Mc Elwain Farm
deal oil & gas Company

 Ft. from N. Line

660 Ft. from S. Line

660 Ft. from E. Line

 Ft. from W. Line

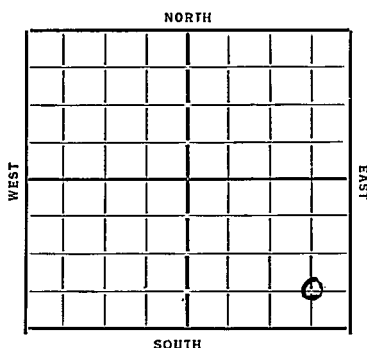

Date
1934

REPORT

<u>2/14</u>	<u>Cellen</u>
<u>2/23</u>	<u>—</u>
<u>3/1</u>	<u>ROH</u>
<u>3/8</u>	<u>— 3/15 —</u>
<u>3/22</u>	<u>Spud</u>
<u>3/29</u>	<u>—</u>
<u>4/5</u>	<u>20" 80'</u>
<u>4/12</u>	<u>20" collapsed skid rig 20' W.</u>
<u>4/19</u>	<u>Rign up</u>
<u>4/26</u>	<u>24" 56'</u>
<u>5/3</u>	<u>—</u>
<u>5/10</u>	<u>254 Prep. Run 15 1/2</u>
<u>5/18</u>	<u>Dlg 475</u>
<u>5/25</u>	<u>Dlg 1340 15 1/2 257 12 1/2 487</u>
<u>5/31</u>	<u>" 1930</u>
<u>6/7</u>	<u>" 2533 10" 2137</u>
<u>6/14</u>	<u>" 2650</u>
<u>6/21</u>	<u>" 2865</u>
<u>6/28</u>	<u>" 2993</u>
<u>7/5</u>	<u>Tag 3120 8" 3020</u>
<u>7/12</u>	<u>TC 3253 Run 6"</u>
<u>7/19</u>	<u>Dlg 3263 6" 2253 over</u>

7/26 3306 30 m Gas

8/2 TD ³³²⁴~~3335~~ 30 m Gas

8/9 TD 3324 Corrected
Run 5"

8/16 — 8/23 —

8/30 TD 3374 Est 70 Bbls per
day Run tubing

9/6 1000 gal acid

9/13 Taking potential

9/19 Chat 3253 TD 3379

1000 acid 98 oil 3% water

COMPLETED

Map No. 40 Sec. 34 Twp. 23 R. 4WWell No. 1-McElwainDeal Oil & Gas Company

Contractor

FIRST REPORT

SECTION PLAT

			0

Ft. from N. Line

660 Ft. from S. Line660 Ft. from E. Line

Ft. from W. Line

RECORD

Location

Cased.....in.,ft.

Rig up

Sand.....

Drilling and Remarks:

Gas.....

Oil.....

Total Depth.....

clean

PRODUCTION

1st 24 hrs. Nat.....

1st 24 hrs. after shot.....

Gas.....Cu. Ft.

Dry Hole.....

Abandoned.....

Date

2-14-34 192 O Mannubush Scout

Map No. 40 Sec. 34 Twp. 23 R. 4W

Well No. 1-7M = Elwain

Deal oil & Gas Company

Contractor

COMPLETED**SECTION PLAT**

Ft. from N. Line

660 Ft. from S. Line

660 Ft. from E. Line

Ft. from W. Line

			0

Location

Rig up

Drilling and Remarks:

1000 acid

98 oil

3% Water

RECORD

Cased in. ft.

Sand Chart 3253

Gas

Oil

Total Depth 3379

PRODUCTION

1st 24 hrs. Nat.

1st 24 hrs. after shot

Gas Cu. Ft.

Dry Hole

Abandoned

Date

9-19-34 192

ORVAL MANNSCHRECK
Scout