

Map No. KANSAS Sec. 34 Twp. 23 R. 4W
 Well No. 5-England Farm
Olsen & Shell Company

NORTH

WEST

EAST

SOUTH

Location

Drilling Remarks

Rig Up

Drilling Remarks

RECORD

Cased in. ft.

Sand

Gas

Oil

Total Depth

PRODUCTION

1st 24 hrs. Nat.

1st 24 hrs. after shot

Gas cu. ft.

Dry Hole

Abandoned


Company

Ft. from N. Line

330 Ft. from S. Line

Ft. from E. Line

990 Ft. from W. Line

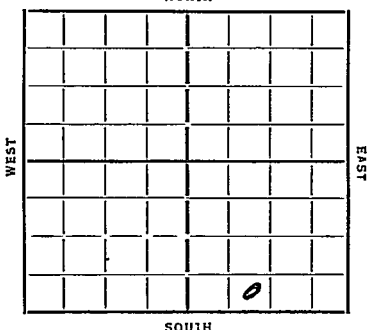

SOUTH

Date _____

REPORT

1935			
3/6	Location		
3/14	Alg		
3/21	Moving		
3/28	Alg 84 1/2	15 1/2	261
4/4	" 2151		
4/11	" 3139		
4/18	Chat 3256	Huntou	3593
	T 17 3605	Rem	7"
4/26	7" 3592	Rect	
5/1	Huntou 3593	T 17 3605	
	1733	Bble.	

COMPLETED

Map No. 40 Sec. 34 Twp. 23 R. 4WWell No. 5-England
Olsen + Shell Company

Contractor

FIRST REPORTS

Ft. from N. Line

330 Ft. from S. Line

Ft. from E. Line

990 Ft. from W. Line

SECTION PLAT

			0

Location ☒

Rig up

Drilling and Remarks:

RECORD

Cased _____ in., _____ ft.

Sand _____

Gas _____

Oil _____

Total Depth _____

PRODUCTION

1st 24 hrs. Nat. _____

1st 24 hrs. after shot _____

Gas _____ Cu. Ft.

Dry Hole _____

Abandoned _____

Date

ORVAL MANNSCHRECK

3-6-35 192 _____ Scout

KANSAS

Map No. 40 Sec. 34 Twp. 23 R. 4WWell No. 5-EnglandOlson + Shell Company

Contractor

COMPLETED

SECTION PLAT

Ft. from N. Line

330 Ft. from S. Line

Ft. from E. Line

990 Ft. from W. Line

Location

Rig up

Drilling and Remarks:

1733 fth

RECORD

Cased _____ in _____ ft.

Sand Hunter 3593

Gas _____

Oil _____

Total Depth 3605

PRODUCTION

1st 24 hrs. Nat. _____

1st 24 hrs. after shot _____

Gas _____ Cu. Ft.

Dry Hole _____

Abandoned _____

Date

ORVAL MANNSCHRECK

5-1-35 192

Scout