


Map No. **KANSAS** Sec. 34 Twp. 23 R. 4WWell No. #1 Myers FarmNational Union Company

NORTH

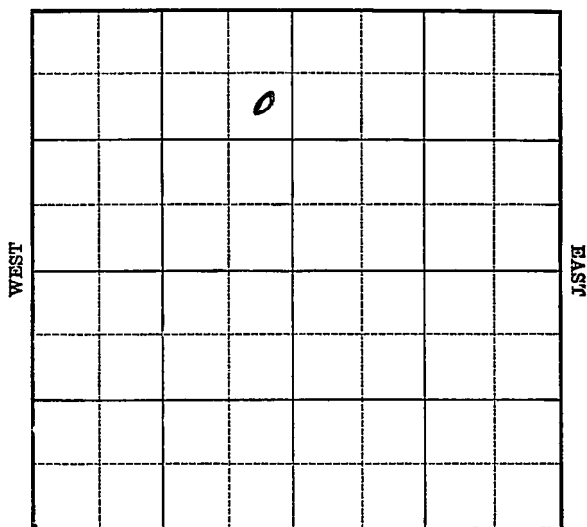

SOUTH

Location _____

Drilling Remarks _____

Rig Up _____

Drilling Remarks _____

RECORD

Cased _____ in. _____ ft.

Sand _____

Gas _____

Oil _____

Total Depth _____

PRODUCTION

1st 24 hrs. Nat. _____

1st 24 hrs. after shot _____

Gas _____ cu. ft. _____

Dry Hole _____

Abandoned _____

Keno

Map No. KANSAS Sec. 34 Twp. 23 R. 4W


Well No. 1 Myers Farm
National Union Company

990 Ft. from N. Line

_____ Ft. from S. Line

330 Ft. from E. Line

_____ Ft. from W. Line

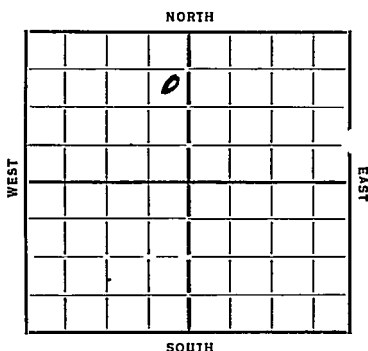

Date

REPORT

1935
2/6 Location
2/14 2/21—2/28—3/7—
3/14 Cellar
3/21 — 3/28—
4/4 B R
4/11 Spud
4/18 Dlg 1355 15 1/2 295
4/26 3160 Run 12 1/2
5/2
5/9 T C 3315 Coring 3588
5/16 T H 3676 7" 36 4/3 Rust
5/23 — 5/29—
6/6 3681 1500 Water
6/13 3685 HFW PB 3387
Rip pipe 3282-87 & w.
6/20 Rip pipe 3350-65
200,000 Gas.
6/28 — 7/3—
7/11 160 Bbls 200,000 Gas
Acidize
7/18

7/31- Hunton 3676

T.D. 3685

F. B. to chat

25 oil

50 water

COMPLETED

KANSAS

Map No. 40 Sec. 34 Twp. 23 R. 4WWell No. 1-MyersNational Union Company

Contractor

FIRST REPORTS SECTION PLAT

990 Ft. from N. Line

Ft. from S. Line

330 Ft. from E. Line

Ft. from W. Line

	0		

Location

Rig up

Drilling and Remarks:

RECORD

Cased.....in.,ft.

Sand.....

Gas.....

Oil.....

Total Depth.....

PRODUCTION

1st 24 hrs. Nat.....

1st 24 hrs. after shot.....

Gas.....Cu. Ft.

Dry Hole.....

Abandoned.....

Date

2-6-35 192ORVAL MANNSCHRECK
Scout

Rem
Map No. 40 Sec. 34 Twp. 23 R. 4W

Well No. 1-Myers

National Union Company

Contractor

SECTION PLAT

	0		

990 Ft. from N. Line

..... Ft. from S. Line

330 Ft. from E. Line

..... Ft. from W. Line

Location.....

Rig up.....

Drilling and Remarks:

PB to chat

25 oil
50 water

RECORD

Cased in ft.

Sand Hutton 3676

Gas.....

Oil.....

Total Depth 3685

PRODUCTION

1st 24 hrs. Nat.....

1st 24 hrs. after shot.....

Gas..... Cu. Ft.

Dry Hole.....

Abandoned.....

Date

OPVAL MANNSCHECK

7-31-35 192

Scout