

Stafford

KANSAS

SEC.	TWP.	R.
34	23S	12W

WELL NO.

I Mattie Gerde

FARM

COMPANY

The Texas Co.

CONTRACTOR


Wildcat

_____ Ft. from N. Line

_____ Ft. from S. Line

_____ Ft. from E. Line

_____ Ft. from W. Line

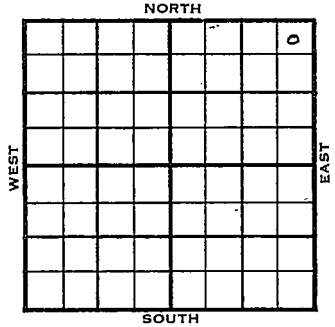

NE NE NE

1955	ELEVATION 1861'	REPORT
------	--------------------	--------

5/25

Top 2949; Heeb 3235; Doug 3268;
 Br. Ls. 3382; Lsg 3410; Congl 3742;
 Viola 3758; Simp 3827; Arb 3886;
 TD 3930; 10th 658;
 DST 3450-68 open 1 hr, rec 15'
 mud 12#, DST 3481-3506 open 1 hr
 rec 125' gsocm, 1170#; DST 3746-70
 open 1 hr rec 30' mud, 105#;
 DST 3766-90 open 1½ hr, rec 90' mud
 292#
 D&A

FIRST REPORT

+

ABANDONED