
FORM 51 25M 3-49 PETROL **KANSAS** Stafford

Section 34 Township 23 Range 13W

Well No. 1 Belb (Delp)

Company Crown Oil

St. Johns townsite

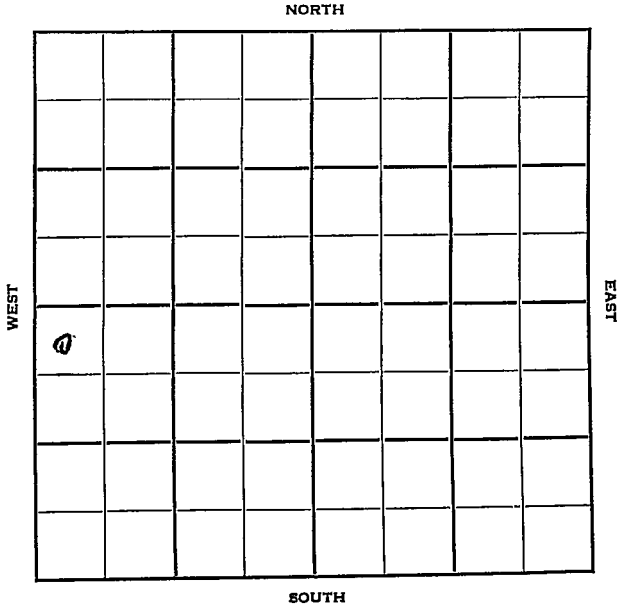

FORM 252-A
5M 10-48 PETROL

Stafford KANSAS

Sec. 34 Twp. 23 R. 13W

Well No. #1 Belb Farm

Crown Oil Company

St. Johns Townsite(Crown, Cont.)


330' Ft. from N. Line

_____ Ft. from S. Line

_____ Ft. from E. Line

330' Ft. from W. Line

NW SW

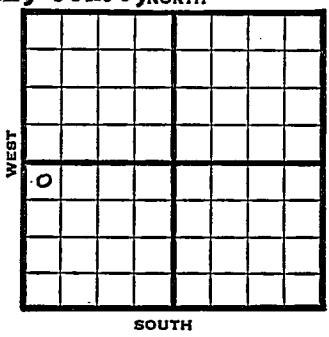

1949	Elev 3712'? REPORT
6/15	Location
6/21	RUR
6/28	8" @ 325' Drlg. 2580'
7/6	Drlg 3691'
7/12	Lansing 3542' 5" @ 3698' TD 3712' 4000 acid
7/20	"
7/27	"
8/3	"
8/10	TD 3712' Lansing 3542' 5"@ 3698' 4000 acid Pump 99 oil + 26% W Pot 39.° Gr Comp COMPLETED

Form 27—100 Bks.—4-48—Petrol

Stafford County Kansas State

Map No. Sec. 34 Twp. 23 R. 13W


Well No. 1 Belb

Crown Oil Company

Crown Contractor

NW SW

FIRST REPORT
SECTION PLAT

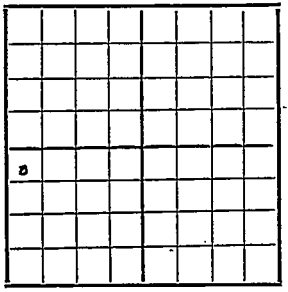

330 Ft. from N. Line

Ft. from S. Line


Ft. from E. Line

330 Ft. from W. Line

St. Johns townsite

Remarks:

Location

 

Date JUN 1 5 1949 Scout S. J. LEWIS.

Form 26 200 Bks. 6-49 Petrol

St. Johns Townsite

Kansas

Map No. K-82 Sec. 34 Twp. 23 R. 13W

Well No. 1 Delp


Crown Oil Company

COMPLETE Contractor

NW SW

El. 1906.

SECTION PLAT

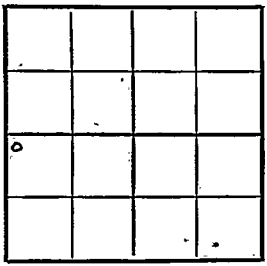

330 Ft. from N. Line

Ft. from S. Line

Ft. from E. Line

330 Ft. from W. Line

Stafford County

Location

Rig up

Drilling and Remarks:

Lime 3542

5" @ 3698

4000 a cid

Pump 99 bbl + 26% oil

Frac

3995

RECORD

Cased in., ft.

Sand

Gas

Oil

Total Depth 3712

PRODUCTION

1st 24 hrs. Nat.

1st 24 hrs. after shot

Gas Cu. Ft.

Dry Hole

Abandoned

Date

AUG 10 1949 19

S. J. LEWIS Scout