

DRILLING WELL COMPLETION REPORT

Well No. 1 Farm Name Anna Redetzke

Date completed May 21, 1948

Description S^W/4 Sec. 34 - 23S - 15W

County Pawnee, State Kansas

Initial production DRY bbls. Total depth 4230 feet

Initial volume _____ cu. ft. _____ lbs. rock pressure

Pipe Line Company _____

Gas Company _____

Remarks: _____

A. E. Dineen

W

Mr. Koontz ~~McDowell~~
Accounting Dept.
✓ Scouting Dept.
Geological Dept.
Pipe Line Dept.
Materials Dept.
Rental Dept.
Legal Dept.
Mr. Leo Meyer
Engineering Dept.
Lease Inventory
Mr. Leo Austin
File

LOCATION NOTICE


KANSAS

TULSA, OKLA., April 21, 1948

KANSAS

WELL NO. 3 ON Anna Redetake FARM KANSAS

WILL BE AS FOLLOWS:

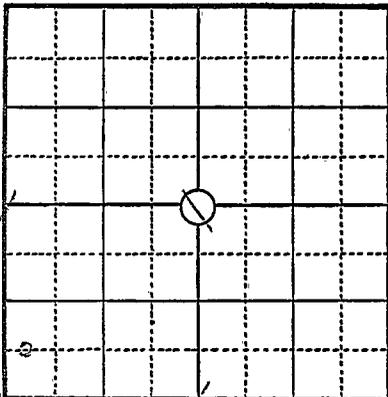

..... FEET FROM NORTH LINE
 FEET FROM EAST LINE
560 FEET FROM SOUTH LINE
330 FEET FROM WEST LINE

IN S1/4 SEC. 31 TWP. 22S RANGE 15W
Barber COUNTY, STATE OF Kansas

REMARKS: Lloyd Snyder, District Supt.
A. H. Johnson, Foreman.

SIGNED A. H. Pierce

- COPIES TO
- MR. KOONTZ
- DISTRICT SUPT.
- ACCOUNTING DEPT.
- SCOUTING DEPT.
- GEOLOGICAL DEPT.
- PIPE LINE DEPT.
- MATERIALS DEPT.
- RENTAL DEPT.
- LEGAL DEPT.
- TAX DEPT.
- ENGINEERING DEPT.
- LEASE INVENTORY
- CLAIM DEPT.
- FILE

*Card
b.p.*

*map
E*

w

Mid-Continent Petroleum Corporation
 A. Redotake Well #1
 SW SW SW Section 54-25-15W
 Pawnee County, Kansas
 Commenced: May 5, 1948
 Completed: May 21, 1948
 Initial Production: Dry Hole

Casing: 8 5/8"

511' 8" w/225 Sax
 298' 2" left in hole.

Formation	Top	Bottom
Clay	0	40
Sand	40	75
Gravel	75	100
Clay	100	240
Shale & clay	240	288
Red Bed	288	305
Red Bed, shale & shells	305	425
Red bed	425	535
Red Bed & shale	535	820
Sandy red Bed	820	940
Lime Anhydrite	940	975
Shale & shells & lime	975	2035
Lime	2035	2085
Shale	2085	2130
Shale & lime	2130	2275
Lime	2275	2335
Sandy lime & shale	2335	2355
Shale & lime	2355	2975
Shale	2975	3025
Lime	3025	3070
Shale & lime	3070	3220
Lime	3220	3615
Shale & lime	3615	3660
Lime	3660	3688
Lime K.O. landing	3688	4000
Conglomerate	4000	4025
Chert Viola	4025	4116
Shale simpson	4116	4128
Conglomerate	4128	4143
Shale, lime & chert	4143	4188
Lime Arbuckle	4188	4230 T.D.