


KANSAS

Section 34 Township 23 Range 15W

Well No. 1 Anna Redetzhe

Company Mid-Continent Pet. Corp.

NORTH

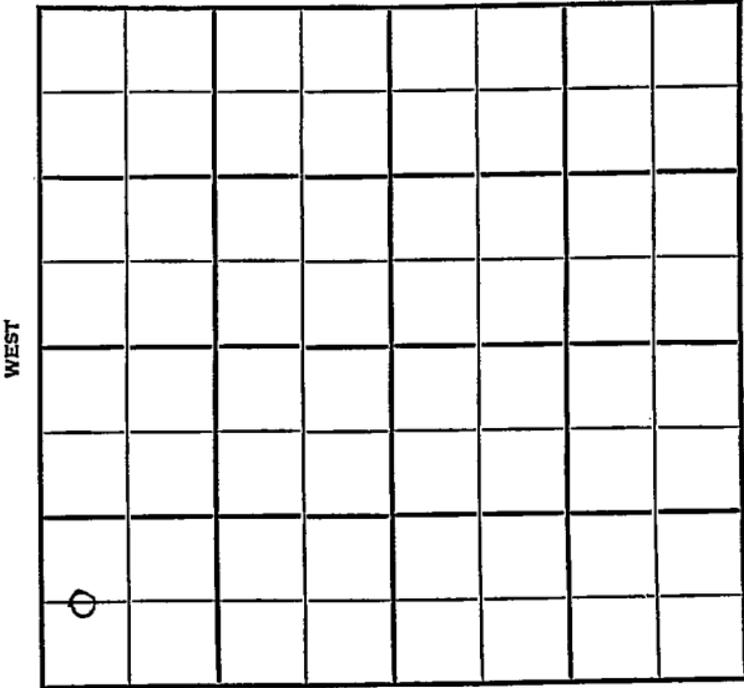

SOUTH

WEST


EAST



Sec. 34 Twp. 23-S R. 15-W

Well No. #1 Anna Redetzke Farm
Mid-Continent Pet. Company
Wildcat

 Ft. from N. Line
660 Ft. from S. Line
 Ft. from E. Line
330 Ft. from W. Line

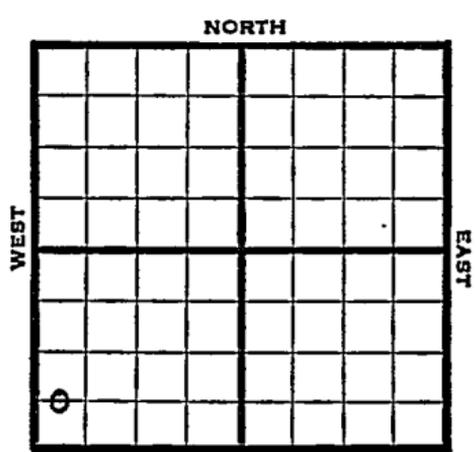

C $W\frac{1}{2}$ SW SW Barnett Drlg. Contractor

1948	Elev. 2014'	REPORT
		Arb. 4200' Test
4/21		Location notice only.
4/29		WOT (ticket) (P.R.)
4/30		" "
5/3		MI & RU "
5/4		Spud 5-4-48 Drlg. 100' "
5/5		8-5/8" set 298' w/225 sacks. "
5/6		Drlg. 425' "
5/7		Drlg. 1280' "
5/10		Drlg. 2335' "
5/11		Drlg. 2605' "
5/12		Drlg. 2900' "
5/13		Drlg. 3160' "
5/14		Drlg. 3410' "
5/17		Top Brown lime 3590' Top White lime 3617' Drilling 3835' "
5/18		Drilling 3972' "
5/19		Drilling 4070' "
5/20		Drilling 4185' green shale. "
5/21		Top Arb. 4198' Cored 4203'-12' Rec. 8' lime. Running Schl. Will plug to day. I.D. 4230' "
5/24		Plug & abandoned 5-21-48 "

OVER

1948

5/26 Lans. 3608'
Viola Chert 4023'
Simp Sd 4116'
Re Arb 4188'
TD 4230'

ABANDONED

Map No. _____ Sec. 34 Twp. 23 R. 15W

Well No. 1 Anna Redetzke


Mid-Continent Petroleum Company

FIRST REPORT

Contractor

C W L SW SW

SECTION PLAT

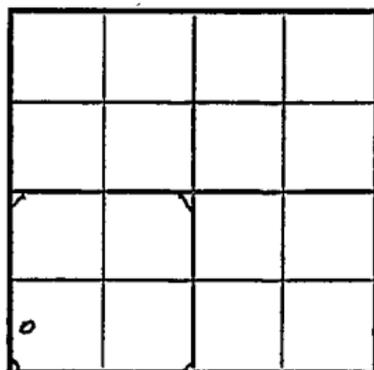

_____ Ft. from N. Line

660 Ft. from S. Line

_____ Ft. from E. Line

330 Ft. from W. Line

Pawnee County

Location x

Rig up _____

Drilling and Remarks:

RECORD

Cased _____ in., _____ ft.

Sand _____

Gas _____

Oil _____

Total Depth _____

PRODUCTION

1st 24 hrs. Nat. _____

1st 24 hrs. after shot _____

Gas _____ Cu. Ft.

Dry Hole _____

Abandoned _____

Date

APR 28 1948 19 _____ S. J. LEWIS Scout

Map No. 83 Sec. 34 Twp. 23 R. 15W

Well No. 1 Anna Redetzke

Mid-Continent Petroleum Company

ABANDONED

Contractor

C W L SW SW

E1.2014
SECTION PLAT

_____ Ft. from N. Line

660 Ft. from S. Line

_____ Ft. from E. Line

330 Ft. from W. Line

Pawnee County

Location _____

Rig up _____

Drilling and Remarks:

Lans 3668
Viola Creek 4028
Smyth 4116
Rebert 4188

RECORD

Cased _____ in., _____ ft.

Sand _____

Gas _____

Oil _____

Total Depth 4230

PRODUCTION

1st 24 hrs. Nat. _____

1st 24 hrs. after shot _____

Gas _____ Cu. Ft.

Dry Hole _____

Abandoned _____

Date

MAY 26 1948

S. J. LEWIS Scout