


Well No. 17 Millhouse Farm

Shellstock Company

NORTH

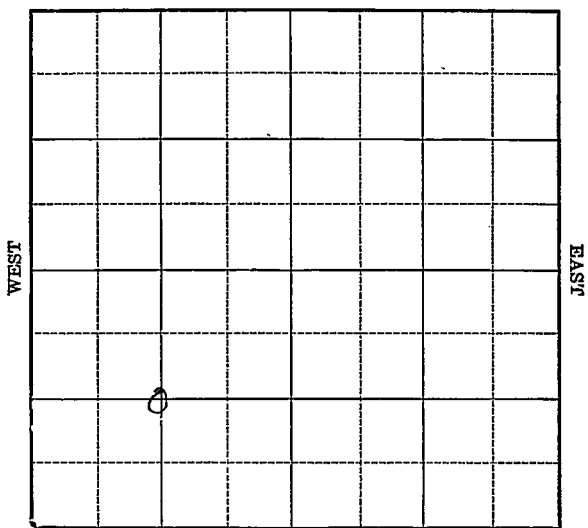

SOUTH

Location

Drilling Remarks

Rig Up.

Drilling Remarks

RECORD

Cased_____in. _____ft.

Sand_____

Gas

Oil

Total Depth_____

PRODUCTION

1st 24 hrs. Nat. _____

1st 24 hrs. after shot_____

Gas_____cu. ft._____

Dry Hole_____

Abandoned_____

Map No. KANSAS Sec. 34 Twp. 23 R. 17^W

Well No. 1- Millhouse Farm

Stelly Oil et al Company

NORTH

_____ Ft. from N. Line

1320 Ft. from S. Line

_____ Ft. from E. Line

1320 Ft. from W. Line

1930

WEST

EAST

SOUTH

Date

REPORT

4/9	Rag (rotary)
4/16	—
4/23	Spud
4/30	" 150'
5/7	hrlg. 2380'
5/14	" 2990'
5/21	" 3200'
5/28	" 3826'
6/4	S.D. 4068'
6/11	Rust 4242'
6/18	hrlg. 4270'
6/25	" 4456'
7/2	Tap Shot 4270'
	Top Simpson 4510'
	hrlg. 4600'
7/9	Fsg. Tools 4605'
7/16	—
7/23	—
7/30	hrlg. 4607'
8/6	" 4640'
	6" - 4612'

8/13- 4⁶ 46- 4653 (S.L.M)

6"- 4642'

8/20- Wrlg. 4704'

" " 4831'


8/27- " " 4956'

9/3- Abandoned 5002'

*Pioneer*Map No. **KANSAS** Sec. *34* Twp. *23* R. *12W**84*Well No. *1 Millhouse**Shelly Oil & Gas* Company

Contractor

SECTION PLAT

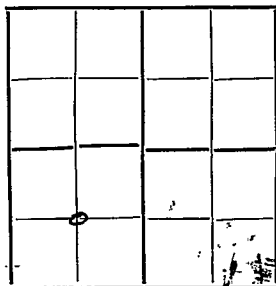

.....Ft. from N. Line

1320 Ft. from S. Line

.....Ft. from E. Line

1320 Ft. from W. Line

FIRST REPORTS

Location.....

Rig up.....

Drilling and Remarks:

Rotary
RLG

RECORD

Cased.....in.,ft.

Sand.....

Gas.....

Oil.....

Total Depth.....

PRODUCTION

1st 24 hrs. Nat.....

1st 24 hrs. after shot.....

Gas.....Cu. Ft.

Dry Hole.....

Abandoned.....

Date

APR 9 - 1930₁₉₂

S. J. LEWIS Scout

Map No. 81 **KANSAS** Sec. 34 Twp. 23 R. 17W

Well No. 1 Millhouse

Shelly Oil & Gas Company

Contractor

SECTION PLAT

_____ Ft. from N. Line

1320 Ft. from S. Line

_____ Ft. from E. Line

1320 Ft. from W. Line

ABANDONED

Location _____

Rig up _____

Drilling and Remarks:

Top Silicoes
4590

RECORD

Cased _____ in., _____ ft.

Sand _____

Gas _____

Oil _____

Total Depth 5702

PRODUCTION

1st 24 hrs. Nat. _____

1st 24 hrs. after shot _____

Gas _____ Cu. Ft.

Dry Hole _____

Abandoned _____

Date

SEP 3 1930

S. J. LEWIS

Scout