


Section 34 Township 23 Range 33W

Well No. #1 Reid

Company Northern Pump

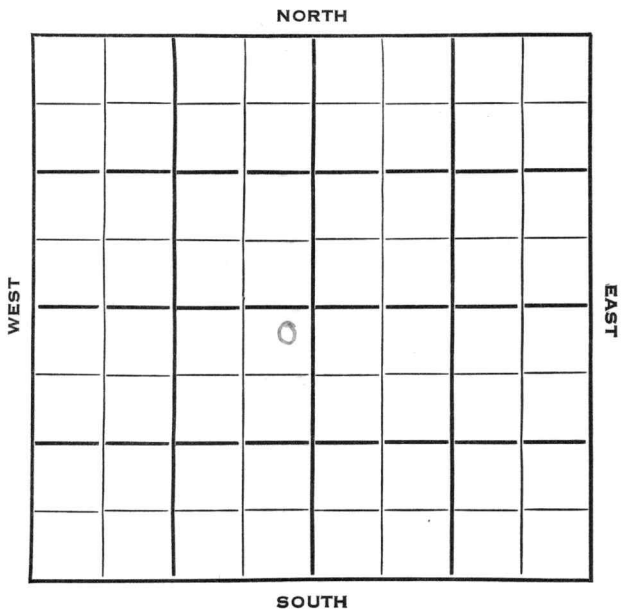

Finney

MANJAS ✓

Sec. 34 Twp. 23 R. 33W

Well No. #1 Reid Farm

Northern Pump Company

Hugoton Pool Contractor


150 Ft. from N. Line

_____ Ft. from S. Line

150 Ft. from E. Line

_____ Ft. from W. Line

NE NE SW

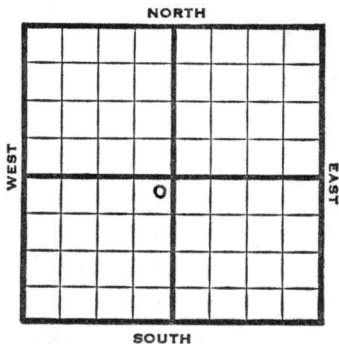

1953

Elev. 2900' REPORT

4/29

Spud 4-23-53
10" @ 400
Drlg. 2460'

5/7

Her 2546, Kr 2570, Win 2600
RTD 2612
7" @ 2602

5/21

CO 2600
Testing

5/28

"

6/3

Spud 4-23-53
Gas Well
TD 2612
10" @ 400
Her 2546, Kri 2570, Win 2600
TD 2612
7" @ 2602
CO to 2600, CO to 2612, dol-frac
PB 2590, 56/2548-62, 48/2572-84
dol-frac
Comp. 2,750,000 gas, 436#

COMPLETED

County Finney State Kansas

Sec. 34 (Blk. 23 (Sur. 33W Map No. 23) (Twp.) (Rge.)

Operator Northern Pump

Well No. 1 Farm Reid

Elev. 2900 Location NE NE SW

COMPLETE									

150 Ft. From N Line SW
 150 Ft. From E Line Quarter

1st. Report

Completion JUN 3 1953

Remarks Hugoton Pool

Spudding Date 4-23-53

Drlg. Data Gas well TD 2612

10" @ 400 Her. 2546 Kri. 2570

Win. 2600 TD 2612 7" @ 2602

CO to 2600 CO to 2612 dol-frac

PB 2590 56/ 2548-62 48/ 2572-84

dol-frac Comp. 2,750,000 gas 436#