


KANSAS

SECTION 34 TOWNSHIP Finney 23 RANGE 32 W

WELL NO. #1 Ben Gerber

COMPANY Stanolind

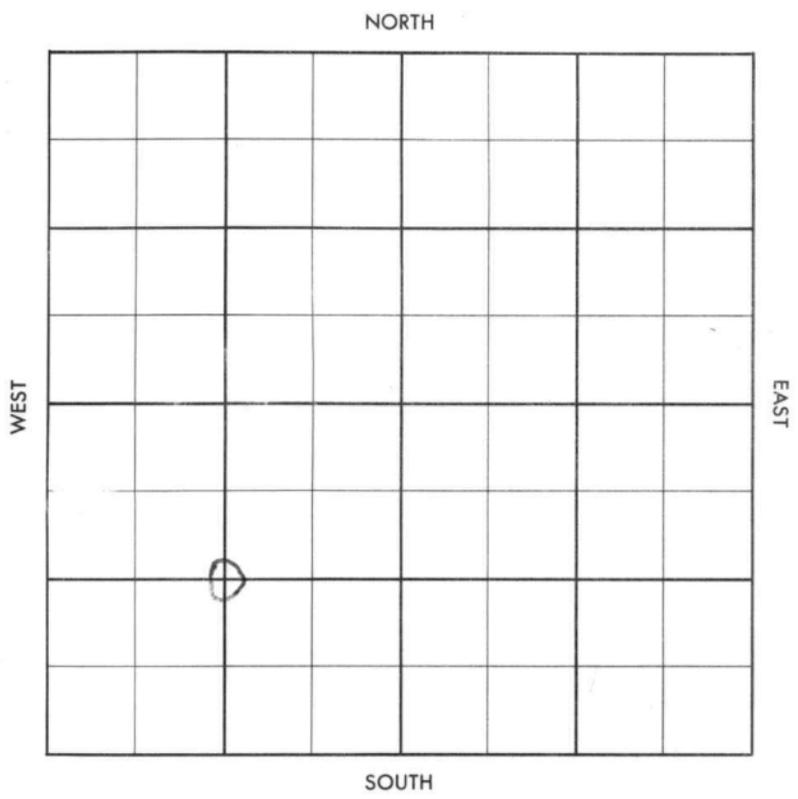

Finney

KANSAS

SEC. 34	TWP. 23	R. 32W
------------	------------	-----------

WELL NO. #1 Ben Gerber FARM

COMPANY Stanolind

CONTRACTOR Noble


Hugoton

_____ Ft. from N. Line
1320' _____ Ft. from S. Line

1390' _____ Ft. from E. Line

_____ Ft. from W. Line

C SW/4

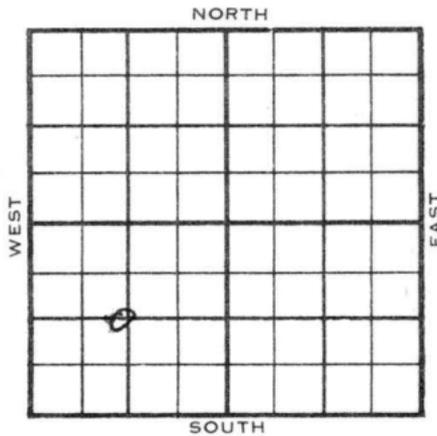

1955	ELEVATION	2835 DF	2838 RB	REPORT	2833 GL
------	-----------	---------	---------	--------	---------

11/9 Loc

12-28 Abd. location

ABANDONED

2835 DF

2838 RB

2833 OL

32W

County **Finney**

Elev.

Sec. **34**

Twp. **23**

Rge.

Company **Stanolind**

Farm Name **Ben Gerber**

No. **1**

TOPS	DEPTH	LOG	DATUM
Anh.			
TP.			
H.			
Tr.			
Dg.			
BL.			
L.			
K.C.			
B.K.C.			
Ce.			
C.			
M.			
M.			
K.			
Mz.			
Mq.			
V.			
S.			
S.			
A.			
R.			
Pe.			
G.			
T.D.			

Loc. in Sec.

G SW/4

1320' SL

1390' EL

Geol.

Contr.

Noble

Pool

Hugoton

NOV 9 '55
FIRST REPORT

Date Comm.

Location

Co.

Lse.

No.

Sec.

T.

R.

2835 DF
2838 RB
2833 GF

County Finney Elev. 2833 GF
 Sec. 34 Twp. 23 Rge. 32W
 Company Stanolind
 Farm Name Ben Gerber No. 1

TOPS	DEPTH	LOG	DATUM
Anh.			
Tp.			
H.			
Tr.			
Dg.			
B.L.			
L.			
K.C.			
B.K.C.			
Ce.			
C.			
M.			
M.			
K.			
Mz.			
Me.			
V.			
S.			
S.			
A.			
R.			
Pe.			
G.			
T.D.			

Loc. in Sec. C SW/4
1320' SL
1390' EL

Geol. _____
 Contr. _____
Noble

Pool Hugoton

ABANDONED

Date Comm. _____

DEC 28 1955

Abd. location _____

Co.

Lse.

No.

Sec.

T.

R.