


Section 34 Township 23 Range 36 WWell No. # 1 KleemanCompany Stanolind

NORTH

WEST

EAST

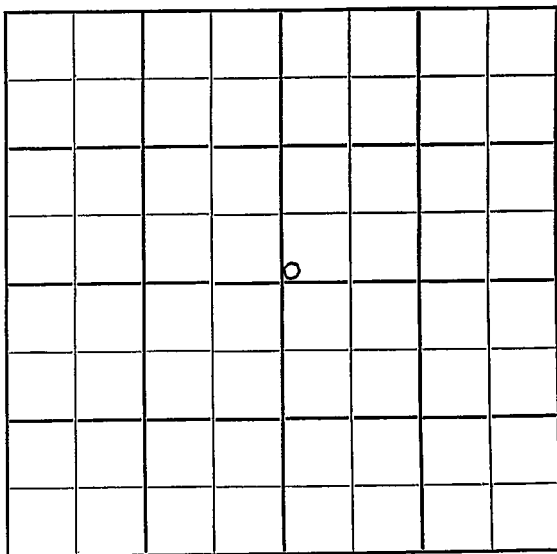

SOUTH

Kearney

KANSAS



Sec. 34 Twp. 23 R. 36 W

Well No. # 1 Kleeman Farm

Stanolind Company

Contractor

Hugoton Pool

Ft. from N. Line

150


Ft. from S. Line

Ft. from E. Line

150

Ft. from W. Line

SW SW NE

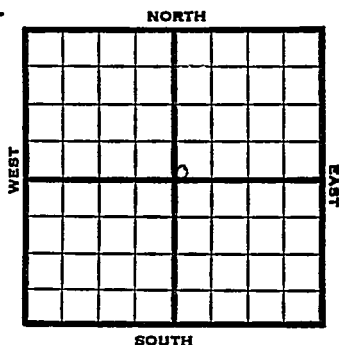

1951

Elev. 3195' REPORT

5/23

Location

9/12

Spud 5-29-51

Gas Well TD 2770

10" @ 746 7" @ 2760

TD 2770 Her. 2590

Win 2652 Ft. Riley 2708

144/2602-26 30/2635-40

90/2656-71 18/2677-80


18/2708-11 30/2717-22

120/2726-40 22,500 A

Comp. 13,376,000 gas 405#

COMPLETED

J. E. TYRA

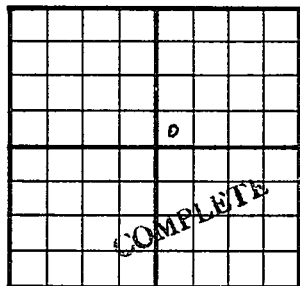County Kearny State KansasSec. 34 (Blk.
Twp.) 23 (Sur.
Rge.) 36W Map No.Operator StanolindWell No. 1 Farm KleemanElev. 3195 Location SW SW NE150 Ft. From S Line NE150 Ft. From W Line Quarter

1st. Report

Completion SEP 12 1951Remarks Hugoton PoolSpudding Date 5-29-51Drlg. Data Gas well TD 277010" @ 746 7" @ 2760 TD 2730Her. 2590 Win. 2652 Ft. Riley 2708144/ 2602-26 30/ 2635-40 90/ 2656-7118/ 2677-80 18/ 2708-11 30/ 2717-22120/ 2726-40 22500 AComp. 13,376,000 gas 405#

J. E. TVRA