


Section 34 Township 23 Range 37 W

Well No. # 1 ~~Hallman~~ SALYER

Company Ed Swearer

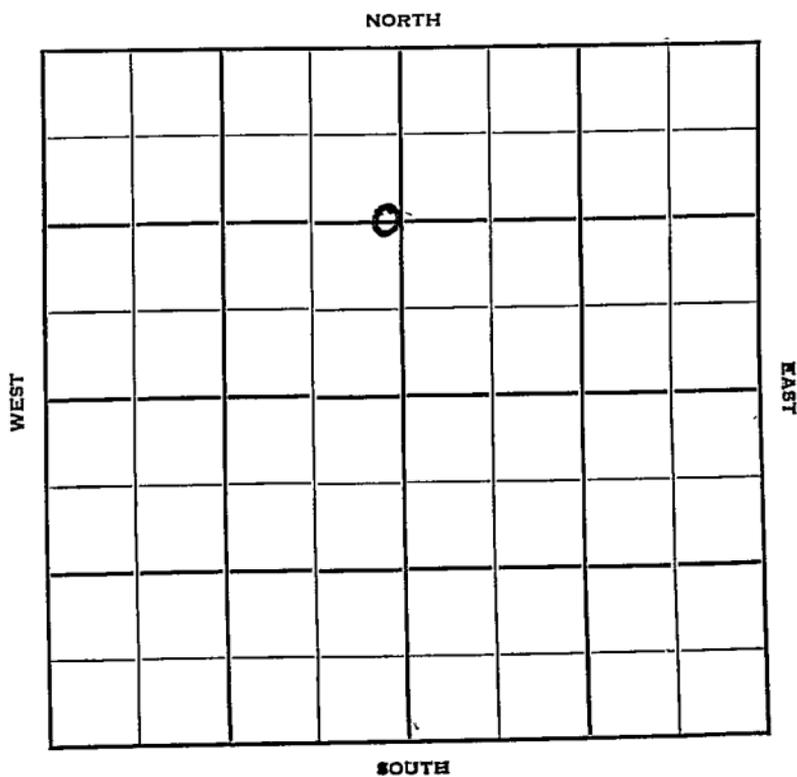

Sec. 34 Twp. 23 R. 37 W

Well No. # 1 ~~Hallman~~ ^{SALYER} Farm

Ed Swearer Company

Hugoton Pool Contractor


1320 Ft. from N. Line

..... Ft. from S. Line

..... Ft. from E. Line

2540 Ft. from W. Line

C E/2 E/2 NW
100' W of C N/2 Sec.

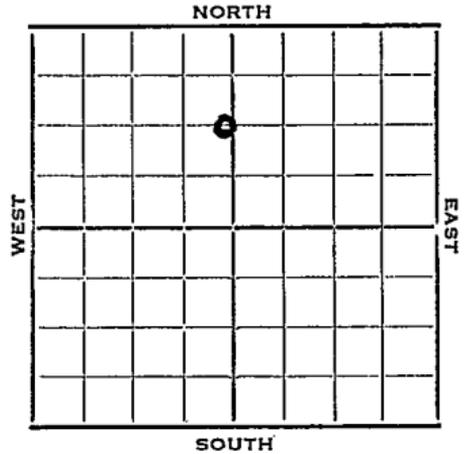

1952 Elev. 3274 REPORT

- 11/26 Location
- 12/4 "
- 12/11 Location
- 12/18 10" @ 400
- 12/25 " " "
- 1/1 RTD 2547 7" @ 2527
- 1/2 NR
- 1/22 Testing
- 1/29 Testing
- 2/5 "
- 2/12 9,000A
- 2/19 NR
- 2/26 N.R.
- 3/12 "
- 3/19 "
- 3/25 Spud 12-5-52
Gas Well
TD 2730
10" @ 400
TD 2547
7" @ 2527
DD 2730

OVER

1953

Information brought forward

3/25 Her 2530, Kri 2552, Win 2580,
Ft. Riley 2640,
CO to 2698 17000 A
Comp 285,000 gas

COMPLETED


County Kearny State Kansas

Sec. 34 (Blk. Twp.) 23 (Sur. Rge.) 37W Map No.

Operator Ed Swearer

Well No. 1 Farm Hallman

Elev. _____ Location 100' W of C N/2 Sec.

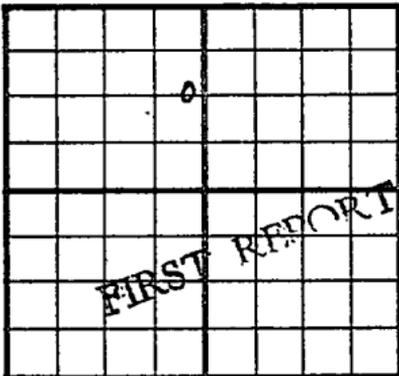

1320 Ft. From N Line NW

2540 Ft. From W Line Quarter

Ist. Report NOV 26 1952

Completion _____

Remarks _____

Spudding Date _____

Drlg. Data Hugoton Pool

Location

J. G. McGEHEE

KANSAS

Map No. _____ Sec. 34 Twp. 23 R. 37W

Well No. 1 Sawyer

Ed Swearer Company

CORRECTION Contractor

100' W of C N/2 Sec.

SECTION PLAT

1320 Ft. from N. Line

_____ Ft. from S. Line

_____ Ft. from E. Line

2540 Ft. from W. Line

Kearny County

Location _____

Rig up _____

Drilling and Remarks:

Reported
#1 Hallman

RECORD

Cased _____ in., _____ ft.

Sand _____

Gas _____

Oil _____

Total Depth _____

PRODUCTION

1st 24 hrs. Nat. _____

1st 24 hrs. after shot _____

Gas _____ Cu. Ft.

Dry Hole _____

Abandoned _____

Date

DEC 22 1952 19

J. G. MCGEHEE

Scout

