

KANSAS

Kearny

Sec. 8 Twp. 23 R. 35W

Well No. #9 Strat Farm _____

Stanolind Company

Wildcat


330 Ft. from N. Line

_____ Ft. from S. Line

_____ Ft. from E. Line

330 Ft. from W. Line

NW/c Elev. 3102

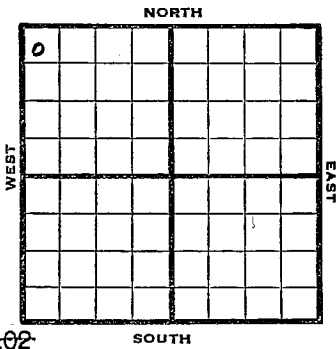

KANSAS

Pool Name Wildcat

Map No. _____ Sec. 8 Twp. 23 R. 35W

Well No. 9 Strat

Stanolind Company

FIRST REPORT

ABANDONED ^{Qual.} E. J. O'22 Contractor


SECTION PLAT

330 Ft. from N. Line

_____ Ft. from S. Line

_____ Ft. from E. Line

330 Ft. from W. Line

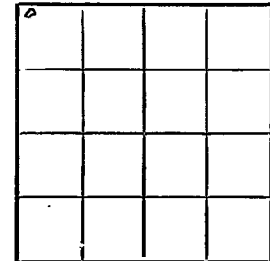

Kearny

Location _____

Rig up _____

Drilling and Remarks:
Blaine 1260
Anhy 2037
Holenberg 2540
Herrington 2589
Krider 2640
Winefield 2696
Ft. Riely 2744
D & A

RECORD

Cased _____ in., _____ ft.

Sand _____

Gas _____

Oil _____

Total Depth 2865

PRODUCTION

1st 24 hrs. Nat. _____

1st 24 hrs. after shot _____

Gas _____ Cu. Ft.

Dry Hole _____

Abandoned _____

Date

JAN 17 1945

19

S. J. LEWIS Scout

1945

REPORT

1/17 Blaine 1260
Anhy 2037
Holenberg 2540
Herrington 2589
Krider 2640
Winefield 2696
Ft Riely 2744
TD 2865
D & A

FIRST REPORT

&

ABANDONED