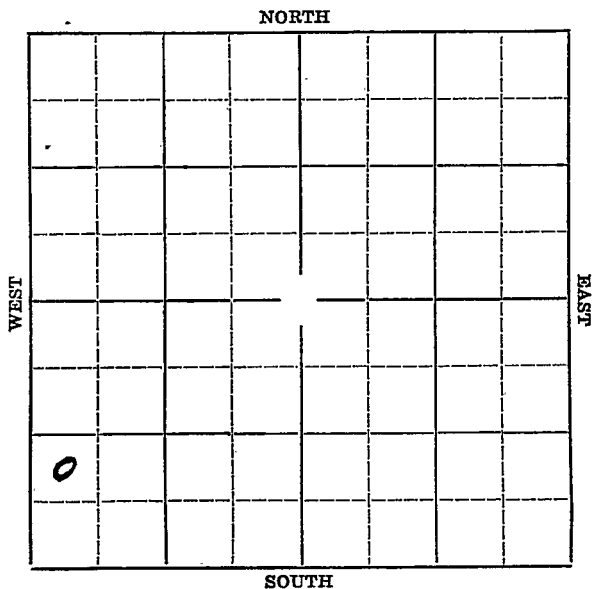
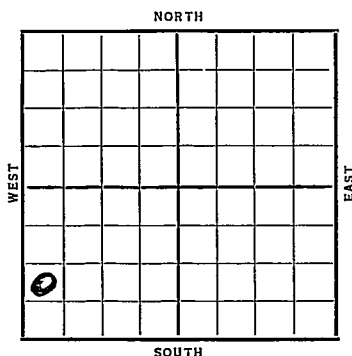


Section 35 Township 23 Range 4-WWell Number #6 AdkinsCompany Olson Oil

Sec. 35 Twp. 23 R. 4WWell No. #6 Adkins FarmOlson Oil. Company Ft. from N. Line990' Ft. from S. Line Ft. from E. Line330' Ft. from W. LineElev. ~~XXXX~~ 1466~~1936~~

REPORT

10/21	Location.
10/29--	11/6--11/12-- 11/19--
11/27	Rig
12/30	12" @ 251'. Drlg. 1192'.
12/10	Drlg. 2450'.
12/17	Chat 3258'. 7" @ 3269' RUST.
12/24	T. D. 3315'. 8 M gas. some oil.
12/29----	
1937	
1/7	T. D. 3315'. 8 M gas.
1/13	Chat 3258'. T. D. 3315'. 8 M gas.

COMPLETED

KANSAS

Map No. 40 Sec. 35 Twp. 23 R. 4WWell No. 6 AtkinsOlson Oil Company

Contractor

SECTION PLAT

0			

 Ft. from N. Line990 Ft. from S. Line Ft. from E. Line330 Ft. from W. Line

FIRST REPORT

Location ✓Rig up

Drilling and Remarks:

RECORD

Cased in., ft.Sand Gas Oil Total Depth

PRODUCTION

1st 24 hrs. Nat. 1st 24 hrs. after shot Gas Cu. Ft.Dry Hole Abandoned

Date

S. J. LEWIS

Scout


KANSAS


Contractor

SECTION PLAT

0			

 Ft. from N. Line990 Ft. from S. Line Ft. from E. Line330 Ft. from W. Line

DATED

Location Rig up

Drilling and Remarks:

Ok & 3258J M Gar.

RECORD

Cased in., ft.Sand Gas Oil Total Depth 3315

PRODUCTION

1st 24 hrs. Nat. 1st 24 hrs. after shot Gas Cu. Ft.Dry Hole Abandoned

Date

JAN 13 1937 19

S. J. LEWIS

Scout