


Reno

Form 51-5M-5-34-Palace

Map No. **KANSAS** Sec. *35* Twp. *23* R. *4 W*

Well No. *2-13 Goering* Farm
Olsen & Shell Company

NORTH

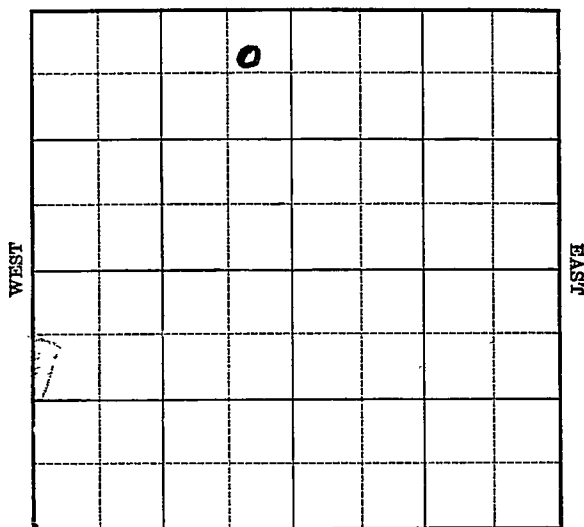

SOUTH

Levin #1

Location _____

Drilling Remarks _____

Rig Up _____

Drilling Remarks _____

RECORD

Cased _____ in. _____ ft.

Sand _____

Gas _____

Oil _____

Total Depth _____

PRODUCTION

1st 24 hrs. Nat. _____

1st 24 hrs. after shot _____

Gas _____ cu. ft.

Dry Hole _____

Abandoned _____

Reno

Map No. KANSAS Sec. 35 Twp 23 R. 4W

Well No. 2-13 Goering Farm
Olson & Shell Company


600 Ft. from N. Line

 Ft. from S. Line

575 Ft. from E. Line

 Ft. from W. Line

Twin #1.

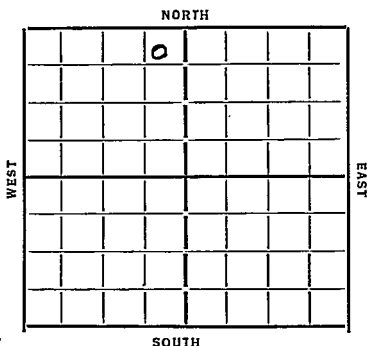

Date 1934

REPORT

6/6 Rig
6/14
6/21 Rign up
6/28 dly 1190
7/5 Cum back 596 dly cement
7/12 dly 2310
7/19 " 3149
7/26 Chst 3232 Hutton 3580
8" 3578
8/2 dly cement
8/8 Hutton 3580 Pay 3584-87
TD 3589 1983 Bbls oil

COMPLETED

KANSASMap No. 40 Sec. 35 Twp. 23 R. 4WWell No. 2B-MooringOlsen & Shell Company

Contractor

Twin #1**SECTION PLAT**600 Ft. **FIRST REPORTS** from N. Line

_____ Ft. from S. Line

575 Ft. from E. Line

_____ Ft. from W. Line

Location _____

Rig up _____

Drilling and Remarks:

Rig**RECORD**

Cased _____ in., _____ ft.

Sand _____

Gas _____

Oil _____

Total Depth _____

PRODUCTION

1st 24 hrs. Nat. _____

1st 24 hrs. after shot _____

Gas _____ Cu. Ft.

Dry Hole _____

Abandoned _____

Date

6-6-37 19**ORVAL MANNSCHRECK**

Scout

KANSAS

Map No. 40 Sec. 35 Twp. 23 R. 4WWell No. 2-B-BoeringOlsen-Snell Company

Contractor

~~COMPLETED~~

SECTION PLAT

	0		

600 Ft. from N. Line Ft. from S. Line575 Ft. from E. Line Ft. from W. LineLocation Rig up

Drilling and Remarks:

Ray 3584-871983 bbls
oil.

RECORD

Cased in. ft.Sand Hunter 3580Gas Oil Total Depth 3589

PRODUCTION

1st 24 hrs. Nat. 1st 24 hrs. after shot Gas Cu. Ft.Dry Hole Abandoned

Date

8-8-34 19

ORVAL MANNSCHRECK

Scout