




Reno

Map No. KANSAS Sec. 35 Twp. 23 R. 4W

Well No. 3-B Goering Farm  
Olson & Shell Company

330 Ft. from N. Line  
\_\_\_\_ Ft. from S. Line  
\_\_\_\_ Ft. from E. Line  
330 Ft. from W. Line

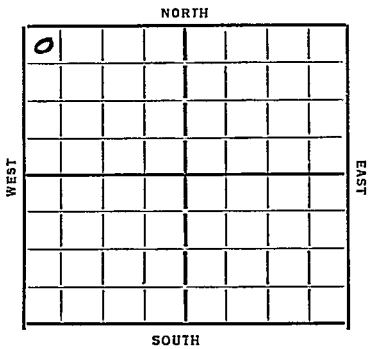

Date 1954

REPORT

7/3 Call  
7/12 Bldg.  
7/19 Bldg Rot. Rig  
7/26 T Chit 3275 A.G. 3327  
S.O. 6" parted  
8/2 — 8/9 —  
8/16 Dly 3069  
8/23 Top Chit 3238 Huntton 3575  
8" 3574 T D 3576 Ruet  
8/30 Oil 3576-81 2500' oil 7 hrs.  
9/5 Huntton 3575 T D 3593  
1940 Bble.

COMPLETED

Map No. 40 Sec. 35 Twp. 23 R. 4W

Well No. 3B - Goering

Olsen & Shell Company

Contractor

**FIRST REPORTS**

330 Ft. from N. Line

\_\_\_\_\_ Ft. from S. Line

\_\_\_\_\_ Ft. from E. Line

330 Ft. from W. Line

**SECTION PLAT**

0			

Location \_\_\_\_\_

Rig up \_\_\_\_\_

Drilling and Remarks:

cellar

**RECORD**

Cased \_\_\_\_\_ in., \_\_\_\_\_ ft.

Sand \_\_\_\_\_

Gas \_\_\_\_\_

Oil \_\_\_\_\_

Total Depth \_\_\_\_\_

**PRODUCTION**

1st 24 hrs. Nat. \_\_\_\_\_

1st 24 hrs. after shot \_\_\_\_\_

Gas \_\_\_\_\_ Cu. Ft.

Dry Hole \_\_\_\_\_

Abandoned \_\_\_\_\_

Date

7-3-37 19

**ORVAL MANNSCHECK** Scout

KANSAS

Form 26 FM Bks 2-29

Map No. 40 Sec. 35 Twp. 23 R. 4W

Well No. 3B-Moring

Olson & Shell Company

Contractor

**COMPLETED**

**SECTION PLAT**

330 Ft. from N. Line

\_\_\_\_\_ Ft. from S. Line

\_\_\_\_\_ Ft. from E. Line

330 Ft. from W. Line

0			

Location \_\_\_\_\_

Rig up \_\_\_\_\_

Drilling and Remarks:

1940 hft

**RECORD**

Cased \_\_\_\_\_ in. \_\_\_\_\_ ft.

Sand Huntton 3575

Gas \_\_\_\_\_

Oil \_\_\_\_\_

Total Depth 3593

**PRODUCTION**

1st 24 hrs. Nat. \_\_\_\_\_

1st 24 hrs. after shot \_\_\_\_\_

Gas \_\_\_\_\_ Cu. Ft.

Dry Hole \_\_\_\_\_

Abandoned \_\_\_\_\_

Date

9-5-34

**ORVAL MANSCHRECK**

Scout