O.W.W.O. O. W. P. B. Rec KANSAS

Form 51—5M—5-34—Palace

Map No. KANSAS Sec. 35 Twp. 23 R. 4W

Well No. #6-A/311 Storing Farm

Abercrombie Shell Company

Singer + Kahan

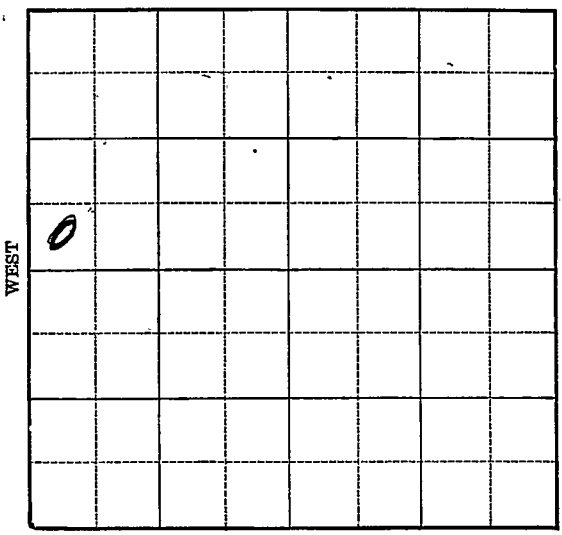

Location

Drilling Remarks

Rig Up

Drilling Remarks

RECORD

Cased ____ in. ____ ft.

Sand

Gas

Oil

Total Depth

PRODUCTION

1st 24 hrs. Nat.

1st 24 hrs. after shot

Gas ____ cu. ft.

Dry Hole

Abandoned

Form 252-A
5M 7-34 MPC

O.W.W.O. O. W. P. B. KANSAS Reno

Map No. KANSAS Sec. 35 Twp. 23 R. 4 W

Well No. ~~6-#6 Gehring "B"~~ Farm

Olcott Shelts

SINGER & KAHAN Company

BURRTON Pool

____ Ft. from N. Line

330 Ft. from S. Line

____ Ft. from E. Line

330 Ft. from W. Line

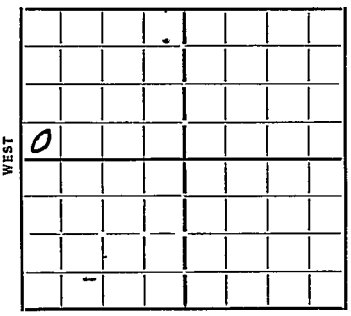

SW SW NW SDX - OFFSET

Date	REPORT
~~1934~~	
11/14	Location
11/22	Rig
11/28	Spud
12/6	12½ 488
12/15	Dly 2353
12/21	" 2872
12/27	" 3575
1/3/35	7" 3576 TD 3577 Boiling
1/10	Chat 3235 B ML 3502
	Hunton 3579 7" 3576 TD
	3590 flow 714 Bbls.
1/17	Set pump unit.
1/24	~~Pot 4857~~ Not to acidize
1/31	
2/7	Pot 4857 Incorrect
	acidizing
2/14	P 1163 Bbls Re acid 2000 Gal
2/20	Hunton 3579 TD 3590
	2000 acid 1624 Bbls.
	COMPLETED

OVER

1955
6/8 W.W.O.

PB 3427' 24/ 3284-90 24/3286-92
24/3294-3000 24/3313-19 4/3318-19
66/3323-40 24/3325-31 24/3334-40
24/3357-63 1500 A
Comp. 10 BOPD 26 BW
Miss. 3235' Hunton 3579'
TD 3590'

FIRST REPORT

COMPLETED

1955
7/13 O. W. P. B.

Old info: - TD 3590'
7" @ 3583 Was Hunt. well
NEW INFO: PB 3427' 48/3284-92;
24/3294-3300; 28/3313-19;
90/3323-40; 24/3334-40; 24/3357-63;
1500 A Pump 10 BO + 26 BWPD
Miss 3235', Hunton 3579'

FIRST REPORT

COMPLETED

Form 26—1M Bks.—2-29

Reno

Map No. 40 Sec. 35 Twp. 23 R. 4W

Well No. 6 B- Goering

Olsen & Shell Company

Contractor

FIRST REPORTS

____ Ft. from N. Line

330 Ft. from S. Line

____ Ft. from E. Line

330 Ft. from W. Line

SECTION PLAT

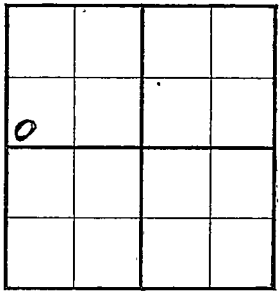

Location ✓

Rig up

Drilling and Remarks:

RECORD

Cased ____ in., ____ ft.

Sand

Gas

Oil

Total Depth

PRODUCTION

1st 24 hrs. Nat.

1st 24 hrs. after shot

Gas ____ Cu. Ft.

Dry Hole

Abandoned

Date

11-14-34 19____

ORVAL MANNSCHRECK Scout

Form 26—M Rev. 9-28

KANSAS

Map No. 40 Sec. 35 Twp. 23 R. 4W

Well No. 6 B Bowring

Olsen & Shell Company

Contractor

COMPLETED

Ft. from N. Line

330 Ft. from S. Line

Ft. from E. Line

330 Ft. from W. Line

SECTION PLAT

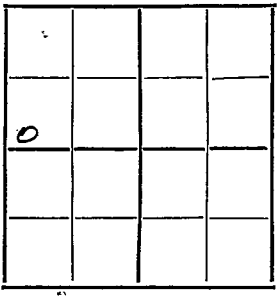

Location

Rig up

Drilling and Remarks:

2000 acid

1624 bbls

RECORD

Cased in., ft.

Sand Hunton 3579

Gas

Oil

Total Depth 3590

PRODUCTION

1st 24 hrs. Nat.

1st 24 hrs. after shot

Gas Cu. Ft.

Dry Hole

Abandoned

Date

2-20-35 192

ORVAL MANNSCHRECK Scout

O.W.W.O.

FORM 513 REV. SUNRAY

OWWO

County Reno Elev. 1469

Sec. 35 Twp. 23 Rge. 4W

Company Singer & Kahan

Farm Name Goering "B" No. 6

TOPS	DEPTH	LOG	DATUM
Anh.			
T.P.			
H.			
Tr.			
Dg.			
B.L.			
L.			
K.C.			
B.K.C.			
Ce.			
C.			
M.			
M.	3235		
K. Hunton	3579		
Mz.			
Mo.			
V.			
S.			
S.			
A			
R.			
P€.			
G.			
T.D.	3590		

Loc. in Sec. SW SW NW

Geol.

Contr.

Pool Burrton

FIRST REPORT

O

COMPLETE JUN 8 '55

Date Comm.

PB 3427 24/ 3284-90 24/ 3286-92

24/ 3294-3000 24/ 3313-19 4/ 3318-19

66/ 3323-40 24/ 3325-31 24/ 3334-40

24/ 3357-63 1500 A

Comp. 10 bopd 26 bw

Co. Lse. No. Sec. T. R.

O. W. P. B.

OWPB

FORM 513 REV. SUNRAY

County Reno Elev. 4469 DF

Sec. 35 Twp. 23S Rge. 4W

Company Singer & Kahn

Farm Name Goering "B" No. 6

TOPS	DEPTH	LOG	DATUM
Anh.			
Tp.			
H.			
Tr.			
Dg.			
B.L.			
L.			
K.C.			
B.K.C.			
Ce.			
C.			
M. ~~Egg~~	3225		
M. Hunton	3575		
K.			
Mz.			
Mo.			
V.			
S.			
S.			
A			
R.			
P€.			
G.			
T.D.			

Loc. in Sec OWPB SW SW NW

Geol.

Contr.

Pool

Offset JUL 13 '55 COMPLETE FIRST REPORT

Date Comm. ~~Old info - OTD 3590; 7" 3583; was Hunt. well;~~

~~New info - PB 3427; 48/3284-92; 24/3294-3300 28/3313-19; 90/3323-40; 24/3334-40; 24/3357-63; 1500 A; pmp 10 bo + 26 bwpd~~

$

Co. Lse. No. Sec. T. R.