


KANSAS

Form 51-5M-1-30-38840

Map No. 40 Sec. 35 Twp. 23^s R. 4^w

Well No. 2 Krebbel Farm _____
Gypsy Oil Company _____

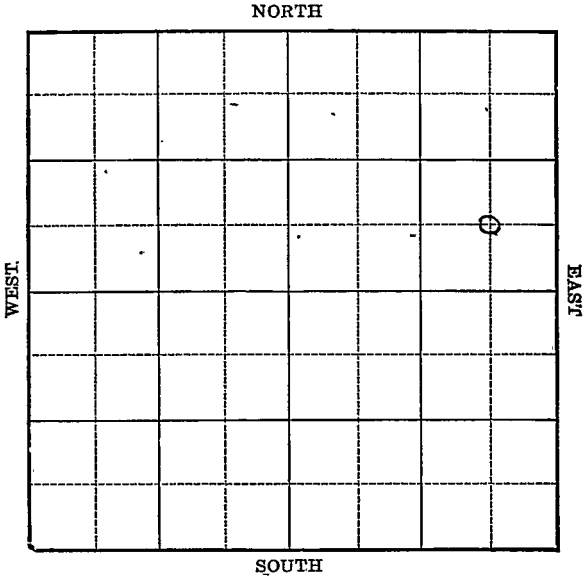

Location _____
Drilling Remarks _____

Rig Up _____
Drilling Remarks _____

RECORD

Cased _____ in. _____ ft.
Sand _____
Gas _____
Oil _____
Total Depth _____

PRODUCTION

1st 24 hrs. Nat. _____
1st 24 hrs. after shot _____
Gas _____ cu. ft.
Dry Hole _____
Abandoned _____

Reno

Map No. KANSAS Sec. 35 Twp. 23 R. 4W

Well No. 2-Krehbriel Farm


Gypsy oil Company

_____ Ft. from N. Line

660 Ft. from S. Line

660 Ft. from E. Line

_____ Ft. from W. Line

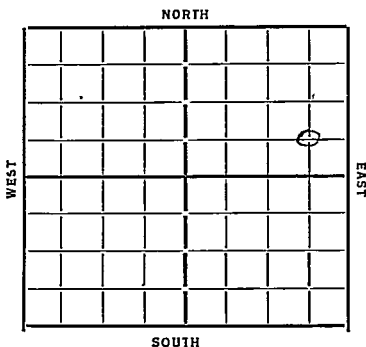

Date
1933

REPORT

9/20 Cellars

9/29 B.M.A.

10/5 _____ 10/11 _____

10/18 Wrlg 295

10/25 Top chat 3252 - 8' at 3257

T.D. 3326 - Bailing

11/1 T.D. 3370 - Est 2.5 bbls/hr.

11/8 Bldg tanks

11/15 292 bbls in 14 hrs

11/22 _____

11/28 Chat 3252' T.D. 3270' 386 bbls

Top water & B.S.

COMPLETED

Map No. 40 Sec. 35 Twp. 23 R. 4W

Well No. 2- Krehbiel

Gypsy Oil Company

Contractor

SECTION PLAT

660 Ft. from N. Line

660 Ft. from S. Line

660 Ft. from E. Line

~~_____~~ Ft. from W. Line

			0

~~COPIED~~
FIRST REPORTS

Location _____

Rig up _____

Drilling and Remarks:

cellar

RECORD

Cased _____ in., _____ ft.

Sand _____

Gas _____

Oil _____

Total Depth _____

PRODUCTION

1st 24 hrs. Nat. _____

1st 24 hrs. after shot _____

Gas _____ Cu. Ft.

Dry Hole _____

Abandoned _____

Date

9/29/33 O. Manschreck Scout

Map No. 40 Sec. 35 Twp. 23 R. 4W

Well No. 2-Krubiel

Gypsy Oil Company

Contractor

COMPLETED

SECTION PLAT

			0

.....Ft. from N. Line

660 Ft. from S. Line

660 Ft. from E. Line

.....Ft. from W. Line

Location.....

Rig up.....

Drilling and Remarks:

38.6 bbls
2% B.S.

RECORD

Cased..... in..... ft.

Sand Chat 3252

Gas.....

Oil.....

Total Depth 3370

PRODUCTION

1st 24 hrs. Nat.....

1st 24 hrs. after shot.....

Gas..... Cu. Ft.

Dry Hole.....

Abandoned.....

Date

11-28-33 O. Marneluck
192 Scout