


Reno

Form 51-5M-11-31-Palace

Map No. **KANSAS** Sec. *35* Twp. *23* R. *4W*

Well No. *4 Kreibel* Farm
Gypsy Oil Company

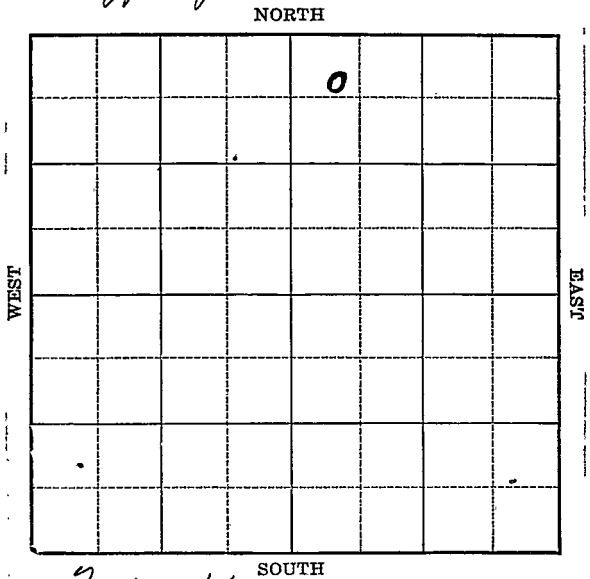

Twin #1.

Location _____
Drilling Remarks _____

Rig Up _____
Drilling Remarks _____

RECORD

Cased _____ in. _____ ft.
Sand _____
Gas _____
Oil _____
Total Depth _____

PRODUCTION

1st 24 hrs. Nat. _____
1st 24 hrs. after shot _____
Gas _____ cu. ft. _____
Dry Hole _____
Abandoned _____

Reno

Map No. KANSAS Sec. 35 Twp. 23 R. 4W

Well No. 4 Kreibel Farm


Gypsy Oil Company

600 Ft. from N. Line

_____ Ft. from S. Line

_____ Ft. from E. Line

475 Ft. from W. Line

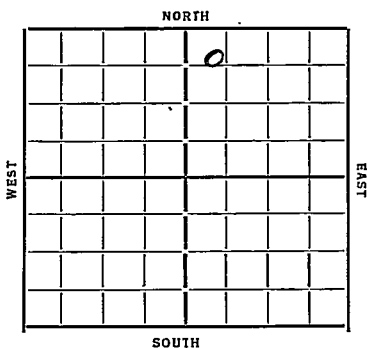

Date

REPORT

1934
5/30 Location
6/7 15 1/2 260
6/14 12 1/2 600 W.O.C.
6/21 Alg 2356
6/28 " 3183
7/5 TC 3241 R. Miss 3517
7/12 8" 3578 Hutton 3578
A.O. 3582 Alg 3588
7/19 3597 TD West 984 Bbls
21 hrs.
7/25 Hutton 3578 TD 3597
1355 Bbls 22 hrs.

COMPLETED

Map No. K49 Sec. 35 Twp. 23 R. 4NWell No. 4 KscitelGyrgyz Oil Company

Contractor

SECTION PLAT

		0	

600 Ft. from N. Line

_____ Ft. from S. Line

_____ Ft. from E. Line

475 Ft. from W. Line

TWIN #1

Location ✓

Rig up _____

Drilling and Remarks:

RECORD

Cased _____ in., _____ ft.

Sand _____

Gas _____

Oil _____

Total Depth _____

PRODUCTION

1st 24 hrs. Nat. _____

1st 24 hrs. after shot _____

Gas _____ Cu. Ft.

Dry Hole _____

Abandoned _____

Date

5/301934ORVAL MANNSCHRECK
Scout

KANSA.

Map No. 40 Sec. 35 Twp. 23 R. 4WWell No. 4-KreppielGypsy Oil

Company

Contractor

COMPLETED

SECTION PLAT

		0	

600 Ft. from N. Line

_____ Ft. from S. Line

_____ Ft. from E. Line

475 Ft. from W. Line

Location _____

Rig up _____

Drilling and Remarks:

1355 lbs
22 hrs

RECORD

Cased _____ in., _____ ft.

Sand Hutton 3578

Gas _____

Oil _____

Total Depth 3597

PRODUCTION

1st 24 hrs. Nat. _____

1st 24 hrs. after shot _____

Gas _____ Cu. Ft.

Dry Hole _____

Abandoned _____

Date

7-25-34 19

ORVAL MANN SCHRECK

Scout