


Section 35 Township 23 Range 4-W

Well Number #5-Adkins

Company Olson Oil

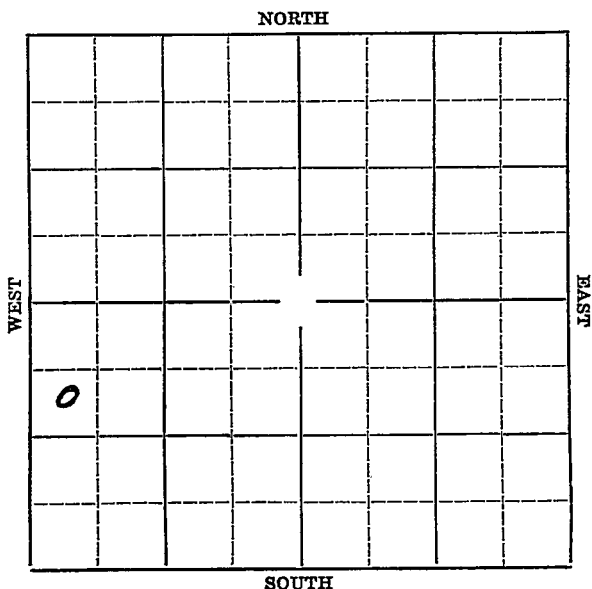


Sec. 35 Twp. 23 R. 4WWell No. #5 Adkins FarmOlson Oil. Company990' Ft. from N. Line

Ft. from S. Line

Ft. from E. Line

330' Ft. from W. Line

Elev. 1466

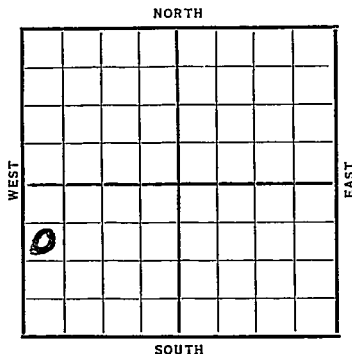~~1956~~

REPORT

10/21 Rig.

10/29 12" @ 260'. WOC.

11/6 Drlg. 2322

11/12 Drlg. 3053

11/19 Chat 3258'. 7" @ 3265'. WOC

11/25 Chat 3258'. T. D. 3317'.

8 M gas.

COMPLETED

KANSASMap No. 40 Sec. 35 Twp. 23 R. 4WWell No. 5 PerkinsOlson Oil Company

Contractor

SECTION PLAT

0			

990 Ft. from N. Line

_____ Ft. from S. Line

_____ Ft. from E. Line

380 Ft. from W. Line**FIRST REPORT**

Location _____

Rig up _____

Drilling and Remarks:

*Rig***RECORD**

Cased _____ in., _____ ft.

Sand _____

Gas _____

Oil _____

Total Depth _____

PRODUCTION

1st 24 hrs. Nat. _____

1st 24 hrs. after shot _____

Gas _____ Cu. Ft.

Dry Hole _____

Abandoned _____

Date

OCT 21 1936

19

S. J. LEWIS Scout

KANSAS

Map No. 40 Sec. 35 Twp. 23 R. 4W.Well No. 5 PerkinsOleum Oil Company

Contractor

SECTION PLAT

0			

990 Ft. from N. Line

_____ Ft. from S. Line

_____ Ft. from E. Line

330 Ft. from W. Line

COMPLETED

Location _____

Rig up _____

Drilling and Remarks:

Cha 83258SM Gas.

RECORD

Cased _____ in., _____ ft.

Sand _____

Gas _____

Oil _____

Total Depth 13317

PRODUCTION

1st 24 hrs. Nat. _____

1st 24 hrs. after shot _____

Gas _____ Cu. Ft.

Dry Hole _____

Abandoned _____

Date

NOV 25 1936

19

S. J. LEWIS

Scout