

KANSAS

Reno

Form 51-5M-11-31-Palace

Map No. _____ Sec. 35 Twp. 23 R. 4WWell No. 1 Gorvin Farm _____
Olsen & Shell Company

NORTH

WEST

EAST

SOUTH

Location _____

Drilling Remarks _____

Rig Up _____

Drilling Remarks _____

RECORD

Cased _____ in. _____ ft.

Sand _____

Gas _____

Oil _____

Total Depth _____

PRODUCTION

1st 24 hrs. Nat. _____

1st 24 hrs. after shot _____

Gas _____ cu. ft.

Dry Hole _____

Abandoned _____

Reno

KANSAS

Map No. _____ Sec. 35 Twp. 23 R. 4^W

Well No. #1 Gorwin Farm


Olsen-Shell Company

660 Ft. from N. Line

_____ Ft. from S. Line

660 Ft. from E. Line

_____ Ft. from W. Line

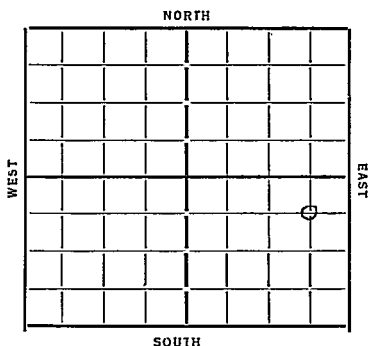

Date
1933

REPORT

3/22 Bldg Rig
3/29 Rig
4/4 Cement 15" 254 - W.O.C.
4/12 dely 1812'
4/19 " 2700'
4/26 T.D. 3186 recement 12"
5/3 Top Chat 3256 8" 3269 Rest
5/10 Show Oil 3296 dely 3305'
5/17 2600' Water 3289-96 - 6" 3302 Pay 3335
- 3374 T.D. flow 112 bbls 24 hrs
5/24 Chat 3256-3374
T.D. 3374
115 bbls per day
3/4 m Gas
(Completed)

Reno
 Map No. *40* **KANSAS** Sec. *35* Twp. *23* R. *4* ^W

Well No. *1* *Gorwin*
Olsen & Sheel Company

Contractor

FIRST REPORTS

660 Ft. from N. Line

..... Ft. from S. Line

660 Ft. from E. Line

..... Ft. from W. Line

SECTION PLAT

Location.....

Rig up.....

Drilling and Remarks:

Blow Rig

RECORD

Cased..... in., ft.

Sand.....

Gas.....

Oil.....

Total Depth.....

PRODUCTION

1st 24 hrs. Nat.....

1st 24 hrs. after shot.....

Gas..... Cu. Ft.

Dry Hole.....

Abandoned.....

Date

MAR 2 2 1933

192

CHAS. L. SHERWOOD

Scout

40 **KANSAS** Sec. 35 Twp. 23 R. 4 W

Well No. 1 *Gorvin*
Olson & Sheer Company

Contractor

COMPLETED

66.0 Ft. from N. Line

Ft. from S. Line

66.0 Ft. from E. Line

Ft. from W. Line

SECTION PLAT

			0

Location

Rig up

Drilling and Remarks:

115 Bes per
 Day

RECORD

Cased 8 in., 3269 ft.
 Sand hat 3256-3374
 Gas
 Oil
 Total Depth 3374

PRODUCTION

1st 24 hrs. Nat.
 1st 24 hrs. after shot
 Gas 3/4 AA Cu. Ft.
 Dry Hole
 Abandoned

Date

MAY 24 1933

192

CHAS. L. SHERWOOD

Scout