

Reno


Form 51-5M-11-31-Palace

Map No. **KANSAS** Sec. *35* Twp. *23* R. *4W*

Well No. *3 Krehbeil* Farm

Gypsy Oil Company

NORTH

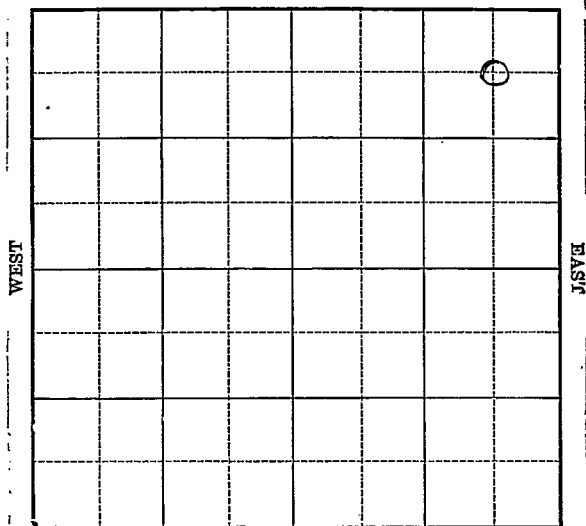

SOUTH

Location

Drilling Remarks

Rig Up

Drilling Remarks

RECORD

Cased in. ft.

Sand

Gas

Oil

Total Depth

PRODUCTION

1st 24 hrs. Nat.

1st 24 hrs. after shot

Gas cu. ft.

Dry Hole

Abandoned

Reno

Map No. KANSAS Sec. 35 Twp 23 R. 4W

Well No. 3 Krehbeil Farm


Gypsy Oil Company

660 Ft. from N. Line

 Ft. from S. Line

660 Ft. from E. Line

 Ft. from W. Line

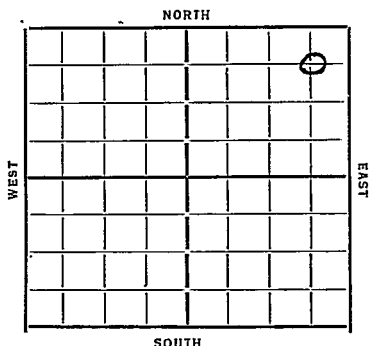

Date 7/9/34

REPORT

2/28 Location
3/8 Rot Rig
3/15 15" at 250 hoc
3/22 Aug 2030
3/29 " 2848
4/18 TD 3370 4 1/2 mil Gas
326 Bbl oil

COMPLETED

KANSAS

Map No. 40 Sec. 35 Twp. 23 R. 4WWell No. 3-15 KrehheilHeavy oil

Company

Contractor

SECTION PLAT

660 Ft. from N. Line

Ft. from S. Line

660 Ft. from E. Line

Ft. from W. Line

			0

FIRST RECORDS

Location ✓

Rig up

Drilling and Remarks:

RECORD

Cased.....in.,ft.

Sand.....

Gas.....

Oil.....

Total Depth.....

PRODUCTION

1st 24 hrs. Nat.....

1st 24 hrs. after shot.....

Gas.....Cu. Ft.

Dry Hole.....

Abandoned.....

Date

2-28-34 192 O. Mannschreck Scout

KANSAS

Map No. 40 Sec. 35 Twp. 23 R. 4WWell No. 3-BrickfieldGypsy Oil Company

Contractor

COMPLETED

SECTION PLAT

			0

660 Ft. from N. Line Ft. from S. Line660 Ft. from E. Line Ft. from W. LineLocation Rig up

Drilling and Remarks:

4½ mil gas326 bbls
oil

RECORD

Cased in., ft.Sand Gas Oil Total Depth 3370

PRODUCTION

1st 24 hrs. Nat. 1st 24 hrs. after shot Gas Cu. Ft.Dry Hole Abandoned

Date

4-18-34 19ORVAL MANNSCHRECK
Scout