

Reno

Map No. **KANSAS** Sec. 35 Twp 23 R. 4W

Well No. 2 Stanley Farm


McPherson Oily Co. Company

_____ Ft. from N. Line

660 Ft. from S. Line

660 Ft. from E. Line

_____ Ft. from W. Line

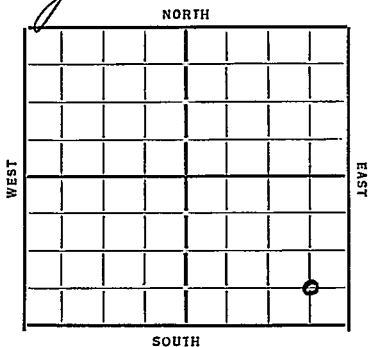

Date
1934

REPORT

<u>4/11</u>	<u>Ponds</u>
<u>4/19</u>	<u>—</u>
<u>4/26</u>	<u>Rig corners</u>
<u>5/3</u>	<u>—</u>
<u>5/10</u>	<u>Rig</u>
<u>5/18</u>	<u>Oily 760 15 1/2 274</u>
<u>5/25</u>	<u>" 2050 13" 484</u>
<u>5/31</u>	<u>" 3071</u>
<u>6/7</u>	<u>Chst 3273 698 3320</u>
	<u>3375 Bailing</u>
<u>6/14</u>	<u>Tubing</u>
<u>6/21</u>	<u>1000 acid N.O.F.</u>
<u>6/28</u>	<u>—</u>
<u>7/3</u>	<u>Chst 3273 TD 3375</u>
	<u>1000 acid 15 oil 30 water</u>

COMPLETED

Map No. 40 Sec. 35 Twp. 23 R. 4 W

Well No. 2- Stanley

McPherson Oil Co Company

Contractor

FIRST REPORT

SECTION PLAT

			0

..... Ft. from N. Line

660 Ft. from S. Line

660 Ft. from E. Line

..... Ft. from W. Line

Location.....

Rig up.....

Drilling and Remarks:

ponds

RECORD

Cased..... in., ft.

Sand.....

Gas.....

Oil.....

Total Depth.....

PRODUCTION

1st 24 hrs. Nat.....

1st 24 hrs. after shot.....

Gas..... Cu. Ft.

Dry Hole.....

Abandoned.....

Date

4-11-34 192 O. Manschreck Scout

Please send in corrections
on Co names.

We show a #1 on this
lease drilled by Perry O. Co.

C. P. Kuhn
Engineering Dept

See correction
on #1 Well

Returned	_____
Cards	_____
Tracing	_____

Map No. 40 Sec. 35 Twp. 23 R. 4W

Well No. 2-Stanley

Meyerson Oil Co Company

Contractor

COMPLETED

SECTION PLAT

			0

Ft. from N. Line

660

Ft. from S. Line

660

Ft. from E. Line

Ft. from W. Line

Location _____

Rig up _____

Drilling and Remarks:

1000 acid
15 oil 30 w

RECORD

Cased _____ in. _____ ft.

Sand Chat 3273

Gas _____

Oil _____

Total Depth 3375

PRODUCTION

1st 24 hrs. Nat. _____

1st 24 hrs. after shot _____

Gas _____ Cu. Ft.

Dry Hole _____

Abandoned _____

Date

7-3-34 19

ORVAL MANNSCHECK
Scout