

Reno


Form 51-5M-11-31-Palace

Map No. \_\_\_\_\_ Sec. 35 Twp. 23 R. 5W

Well No. 1- H. Patten Farm

Mylius et al Company

NORTH

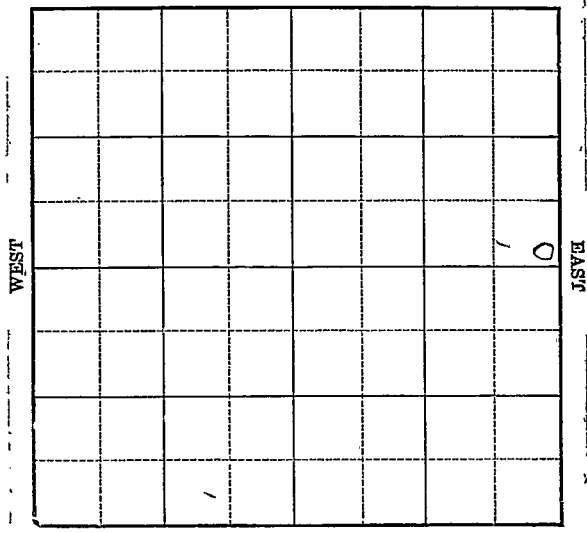

SOUTH

Location \_\_\_\_\_

Drilling Remarks \_\_\_\_\_

\_\_\_\_\_

\_\_\_\_\_

Rig Up \_\_\_\_\_

Drilling Remarks \_\_\_\_\_

\_\_\_\_\_

\_\_\_\_\_

RECORD

Cased \_\_\_\_\_ in. \_\_\_\_\_ ft.

Sand \_\_\_\_\_

Gas \_\_\_\_\_

Oil \_\_\_\_\_

Total Depth \_\_\_\_\_

PRODUCTION

1st 24 hrs. Nat. \_\_\_\_\_

1st 24 hrs. after shot \_\_\_\_\_

Gas \_\_\_\_\_ cu. ft.

Dry Hole \_\_\_\_\_

Abandoned \_\_\_\_\_

Map No. \_\_\_\_\_ Sec. 35 Twp. 23 R. 5W

Well No. 1-H. Patten Farm


mylius etal Company

\_\_\_\_\_ Ft. from N. Line

250 Ft. from S. Line

250 Ft. from E. Line

\_\_\_\_\_ Ft. from W. Line

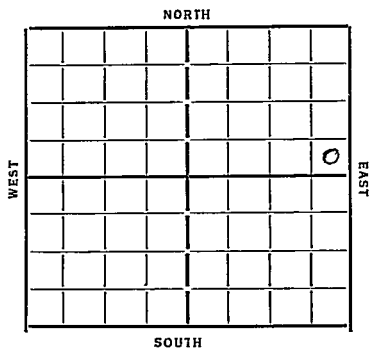

Date  
1933

REPORT

7/26 Pond  
8/12 Bldg Rig  
8/19 spud  
8/17 15" 190' Only 1585  
8/23 dly 2598"  
8/30 K.O. line 2690' Only 3107  
9/6 T.M.H 3375 8" 3387 TD 3398-RVST  
9/13 —  
9/20 show oil @ 406-11 - 1700' water 200' oil 3415  
dly 3489 - 2700' water  
9/29 TD 3568 - RVST.  
10/6 6" 3569 sand 3746 dly 3744 Base line 3585  
10/11 Wilcox 3857 - Show oil & water  
dreq 3885  
10/18 Viola 3835 - Wilcox 3857' TD 3411  
H.F.W. - 40' & 0.

**COMPLETED**  
**ABANDONED**

Map No. 40 Sec. 35 Twp. 23 R. 5W

Well No. 1 H. Patten  
Mylius et al Company

Contractor

SECTION PLAT

			0

.....Ft. from N. Line

250 Ft. from S. Line

250 Ft. from E. Line

.....Ft. from W. Line

**FIRST REPORTS**

Location.....

Rig up.....

Drilling and Remarks:

Sand

**RECORD**

Cased.....in., .....ft.

Sand.....

Gas.....

Oil.....

Total Depth.....

**PRODUCTION**

1st 24 hrs. Nat.....

1st 24 hrs. after shot.....

Gas.....Cu. Ft.

Dry Hole.....

Abandoned.....

Date

7/26/33 192 O. Manschreck Scout

Map No. 40 Sec. 35 Twp. 23 R. 5W

Well No. 1-H. Patten

Mylins et al Company

Contractor

**COMPLETED**

**ABANDONED**

.....Ft. from N. Line

250 Ft. from S. Line

250 Ft. from E. Line

.....Ft. from W. Line

**SECTION PLAT**

			0

Location.....

Rig up.....

Drilling and Remarks:

*HFW*  
*Q+A*

**RECORD**

Cased..... in., ..... ft.

Sand Viola 3835

Gas Wilcox 3857

Oil.....

Total Depth 3911

**PRODUCTION**

1st 24 hrs. Nat.....

1st 24 hrs. after shot.....

Gas..... Cu. Ft.

Dry Hole.....

Abandoned.....

Date

10-8-33 192 C. M. Munnich scout