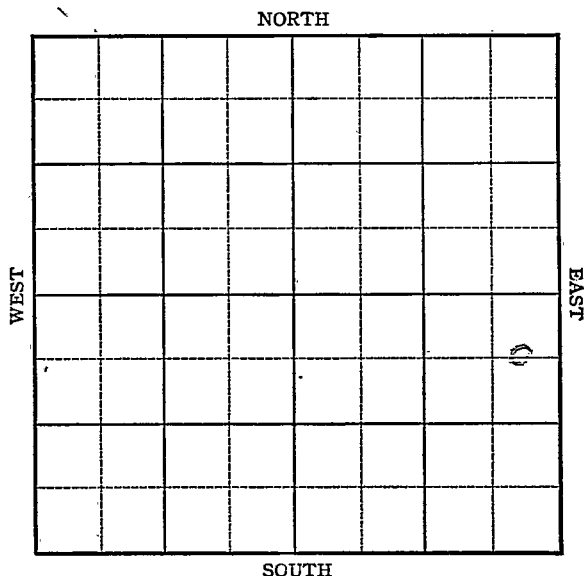


KANSAS

Stafford County

FORM 51 5M 11-44 PETROL

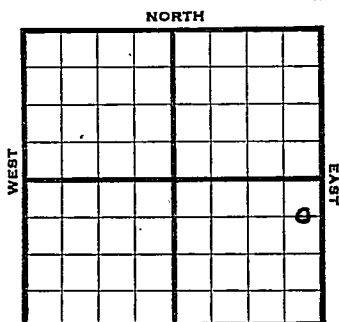
Section 35 Township 23S Range 11WWell No. #1 R. C. ArdreyCompany Sinclair-Prairie

KANSAS

Stafford

Sec. 35 Twp. 23 R. 11WWell No. #1 R.C. Ardrey FarmSinclair-Prairie Company

Zenith

660 Ft. from N. Line Ft. from S. Line330 Ft. from E. Line Ft. from W. LineCEL NE SE 7 0 1811

SOUTH

1945

R E P O R T

3/21 Location

3/29 RUR

4/5 10" @ 213
Drlg. 1365'

4/12 Drlg. 2615

4/20 Drlg. 3445'

4/27 Viola 3713-16

TD 3716

5" @ 3712' RUST

5/3 " " " "

5/10 " " " "

5/17 Viola 3711 corrected

TD 3714

5" @ 3711

5 gals. oil per hr.

TD 3735 5000 acid.

5/31 Swab 4 oil in 6 hrs.

Drlg. 4795'

6/13 Viola 3711.

5" @ 3711

Simp 3932

5000 acid

Pump 15 Pot.

42 O Gr

TD 3871'

COMPLETED

Pool Name Z enithMap No. 47 Sec. 35 Twp. 23 R. 11WWell No. 1 R. C. ArdreySinclair-Prairie

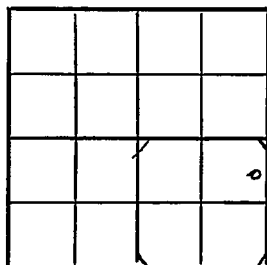
Company

FIRST REPORT

Contractor

C E L N E S E

SECTION PLAT

660 Ft. from N. Line Ft. from S. Line330 Ft. from E. Line Ft. from W. LineStaffordLocation XRig up Drilling and Remarks:

RECORD

Cased in., ft.Sand Gas Oil Total Depth

PRODUCTION

1st 24 hrs. Nat: 1st 24 hrs. after shot Gas Cu. Ft.Dry Hole Abandoned

Date

MAR 21 1945

19

S. J. LEWIS

Scout

Kansas Pool Name ZenithMap No. 47 Sec. 35 Twp. 23 R. 11WWell No. 1- R. C. ArdreySinclair-Prairie

Company

COMPLETE

Contractor

C E L N E S E

E 1/4**SECTION PLAT**660 Ft. from N. Line Ft. from S. Line330 Ft. from E. Line Ft. from W. Line

			0

Stafford CountyLocation Rig up

Drilling and Remarks:

1/2" 37115" 3711Comp 38325000 ac 1/2Pump 15 B.D.428 9/2**RECORD**Cased in., ft.Sand Gas Oil Total Depth 3824**PRODUCTION**1st 24 hrs. Nat. 1st 24 hrs. after shot Gas Cu. Ft.Dry Hole Abandoned

Date

JUN 13 194519S. J. LEWIS

Scout