

Section 35 Township 23 Range 11W

Well No. #1 Arbrey

Company Anschutz Drlg.

NORTH

						0	

WEST

EAST

SOUTH

Stafford

Sec. 35 Twp. 23 R. 11W

Well No. #1 Arbrey Farm

Anschutz Drlg. Company

Anschutz - Contr. Contractor


990' Ft. from N. Line

\_\_\_\_\_ Ft. from S. Line

990' Ft. from E. Line

\_\_\_\_\_ Ft. from W. Line

SW NE NE

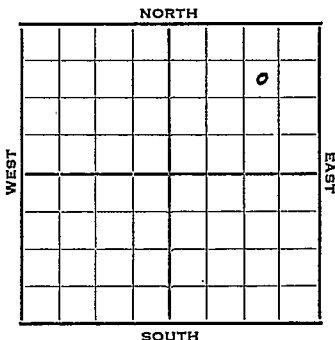

1952	Elev. 1811' REPORT
5/21	Spud 5-17-52 8" @ 250 Anhy 511 Drlg. 1665'
5/28	Br Li 3286    Lans. 3327 DST 3378-89 1hr. 30' M    69# Drlg. 3700'
6/4	Spud 5-17-52 D&A TD 3760' 8" @ 250' Anhy 511                      Br Li 3286 Lans. 3327 DST 3378-89 open 1 hr. rec. 30' mud Viola 3707 DST 3732-38 open 1 hr. rec. 115' sg & ocmw 120' sw TD 3760 D&A  <p style="text-align: center;"><b>ABANDONED</b></p>

County **Stafford** State **Kansas**

Sec. **35** (Blk. Twp.) **23** (Sur. Rge.) **IW** Map No.

Operator **Anschutz Drlg.**

Well No. **1** Farm **Arbrey**

Elev. \_\_\_\_\_ Location **SW NE NE**


**LAST REPORT**

**990** Ft. From **N** Line **NE**

**990** Ft. From **E** Line Quarter

1st. Report **MAY 21 1952**

Completion. \_\_\_\_\_

Remarks \_\_\_\_\_

**Anschutz - Contr.**

Spudding Date **5-17-52**

Drlg. Data \_\_\_\_\_

**8" @ 250 Anhy 511 Drlg. 1665**

**J. G. McGEHEE**

