
FORM 51

Stafford KANSAS

Section 35 Township 23 Range 13 W

Well No. # 1 Asher

Company Brooks Hall et al

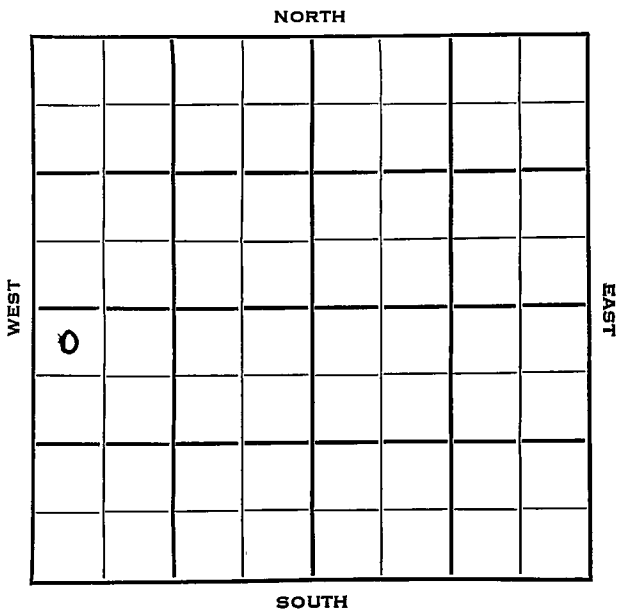

FORM 252-B

Stafford KANSAS ✓

Sec. 35 Twp. 23 R. 13W

Well No. #1 Asher Farm

Brooks Hall et al Company

Contractor


330 Ft. from N. Line

Ft. from S. Line

Ft. from E. Line

330 Ft. from W. Line

NW NWSW

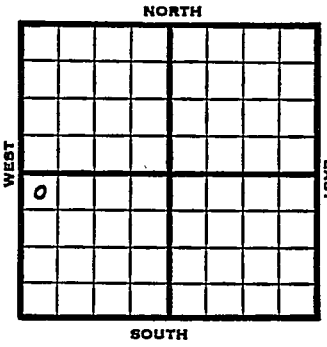

1952	Elv. 1898' REPORT
12/3	Location
12/11	8⅝ @ 277 Ø2085
12/18	Heeb 3331 Br 1 3466 Lans 3494 DST 3522-48 1 Hr. 255' O&GCM 60' SW 910# Ø3677
12/23	Spud 12-4-52 D & A TD 3960' 8⅝ @ 277 Heeb 3331' Br. lime 3466' Lans. 3494' DST 3522-48 open 1 hr. rec 255' O &GCM 60' SW 910# DST 3721-45, open 3/4 hr. rec 30' mud O# B KC 3754' Cong. 3810' Viola 3831 Simp. sh. 3868' Simp. sd. 3902' DST 3874-3905 open 3/4 hr. rec 8' mud O# Arb. 3927' TD 3960' D & A ABANDONED

FORM 275 FOR SALE BY KANSAS BLUE PRINT CO.


County Stafford State Kansas

Sec. 35 (Blk. Twp.) 23 (Sur. Rge.) 13W Map No.

Operator Brooks Hall etal.

Well No. 1 Farm Asher

Elev. Location NW NW SW

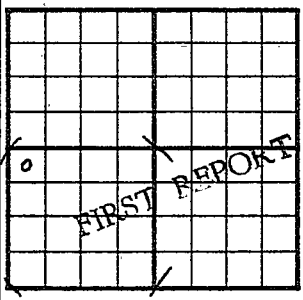

330 Ft. From N Line SW

330 Ft. From W Line Quarter

1st. Report DEC 3 1952

Completion

Remarks

Spudding Date

Drlg. Data

Location

J. G. McGEHEE

FORM 275 FOR SALE BY KANSAS BLUE PRINT CO.


County Stafford State Kansas

Sec. 35 (Blk. Twp.) 23 (Sur. Rge.) 13W Map No.

Operator Brooks Hall etal.

Well No. 1 Farm Asher

Elev. 1898 Location NW NW SW

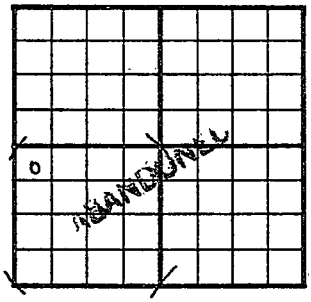

330 Ft. From N Line SW

330 Ft. From W Line Quarter

1st. Report

Completion DEC 23 1952

Remarks

Spudding Date 12-4-52

Drlg. Data D & A TD 3960

8" @ 277 Heeb. 3331 Br. lime 3466

Lans. 3494 DST 3522-48 open 1 hr.

Rec. 255' o & gcm 60' sw 910#

DST 3721-45 open 3/4 hr. Rec. 30' mud

0# B KC 3754 Cong. 3810 Viola 3831

Simp. sh. 3868 Simp. sd. 3902

DST 3874-3905 open 3/4 hr. Rec. 8' mud

0# Arb. 3927 TD 3960

D & A

J. G. McGEHEE