


Section 35 Township 23 Range 18W

Well No. 1 Bender

Company Welch & Olsson Drlg.

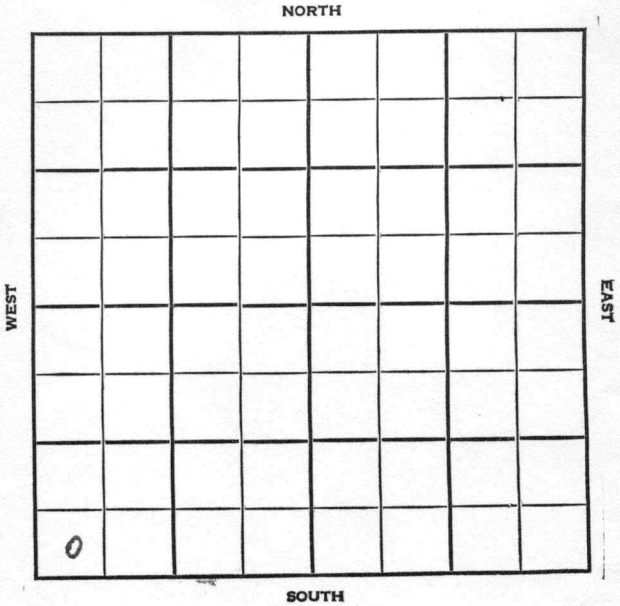

SEC.	TWP.	R.
35	23	18W

WELL NO.

1 Bender

FARM

COMPANY

Welch & Olsson Drlg.

CONTRACTOR

Co. Tools


Wildcat

_____ Ft. from N. Line

330 _____ Ft. from S. Line


_____ Ft. from E. Line

330 _____ Ft. from W. Line

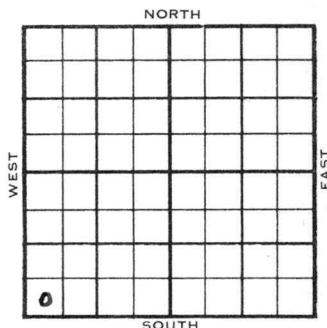

SW SW SW

	ELEVATION	REPORT
1955	2130'	
1/26	Surface Set WOC	
2/16	Spud 1-22-55 Spud 1-22-55 - D&A TD 4545' 8" @ 215' Anhy 1185', Heeb. 3754', Br lime 3865, Lans. 3873', Cong. 4329', Ch. Cong. 4405' DST 4325-4406', opn 1 hr., rec. 50' mud, 250# DST 4407'-16', opn 1 hr., rec. 50' mud, 1200# DST 4416-26', opn 1½ hrs., rec/ 40' mud, 340# DST 4426-46', opn 1½ hrs., rec. 120' sgcsw, 920# Kh. 4478' DST 4470-87', opn 1 hr., rec. 30' mud, 1130# Viola 4510' TD 4545' D&A	
ABANDONED		

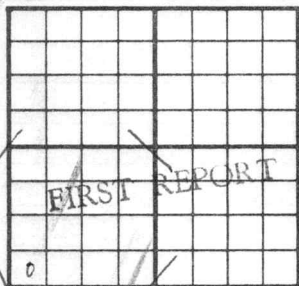County Pawnee State KansasSec. 35 (Blk.) 23 (Sur.) 18W Map No.Operator Welch & Olsson Drlg.Well No. 1 Farm BenderElev. _____ Location SW SW SW330 Ft. From S Line SW330 Ft. From W Line Quarter1st. Report JAN 26 1955

Completion _____

Remarks _____

Co. toolsSpudding Date 1-22-55Drlg. Data Wildcatsurface set WOC

FABEN GILSTRAP

County Pawnee State Kansas
 Sec. 35 (Blk.) 23 (Sur.) 18W Map No.
 Operator Welch & Olsson Drlg.
 Well No. 1 Farm Bender
 Elev. 2130 Location SW SW SW



330 Ft. From S Line SW
330 Ft. From W Line Quarter

1st. Report

Completion FEB 1 6 1955

Remarks Wildcat

Co. tools

Spudding Date 1-22-55

Drlg. Data D & A TD 4545

8" @ 215 Anhy 1185 Heeb. 3754

Br. lime 3865 Lans. 3873 Cong. 4329

Ch. Cong. 4405 DST 4325-4406 open 1 hr.

Rec. 50' mud 250# DST 4407-16

open 1 hr. Rec. 50' mud 1200#

DST 4416-26 open 1½ hr. Rec. 40' mud

340# DST 4426-46 open 1½ hr. Rec.

120' sgcsw 920# Kh. 4478 DST 4470-87

open 1 hr. Rec. 30' mud 1130#

Viola 4510 TD 4545

D & A

FABEN GILSTRAP