

KANSAS


Finney county

FORM 51 5M 6-46 PETROL

Section 35 Township 23 Range 33-W

Well No. #1, Neiderklein

Company Stanolind Oil and Gas Company

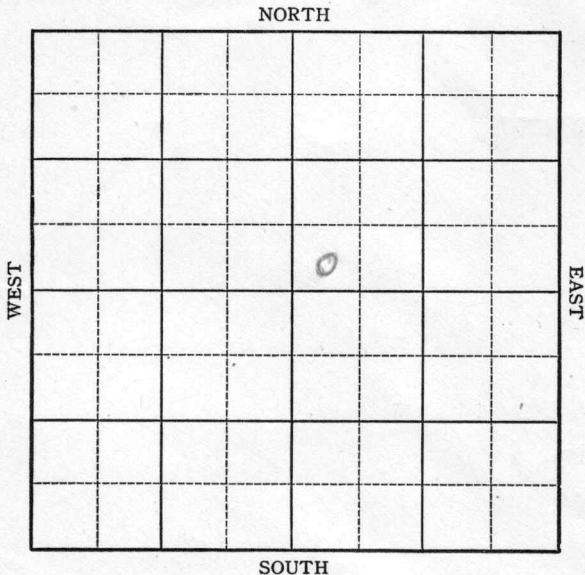

KANSAS Finney County

Sec. 35 Twp. 2523 R. 33W

Well No. #1 Neiderklein Farm

Stanolind Company


Hugoton

Ft. from N. Line

50 Ft. from S. Line

Ft. from E. Line

50 Ft. from W. Line

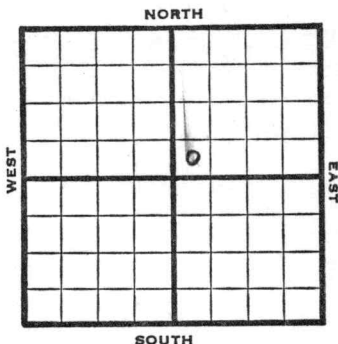

SW NE

Elev. 2894' REPORT

1946

5/29

Location

6/5

RUR

6/12

8" @ 960'

Drlg 2500'

6/18

TD 2697'

6" @ 2695, RUST

6/26

" " "

7/3

50 shots 2789-99

108 shots 2608-24

160 shots 2650-70

6000 acid

7/9

" "

7/16

" "

7/23

" "

7/30

" "

8/6

186 shots 2584-2624

5000 acid

8/13

" " "

8/20

Drlg 2715'

8/27

TD 2715'

66 shots 2553-64-5000 acid

9/5

" " "

9/10

" " "

9/18

6" @ 2695'

Perf

25,000 acid

OVER

1946

INFORMATION CARRIED FORWARD

1,620,000 gas

TD 2715'

RPR 385#

COMPLETED

KANSAS Kansas Pool Name Hugoton

Map No. NE Sec. 35 Twp. 25 R. 33W

Well No. 1 Neiderklein

Stanolind Company

FIRST REPORT Contractor

SW NE

SECTION PLAT

 Ft. from N. Line

50 Ft. from S. Line

 Ft. from E. Line

50 Ft. from W. Line

		o	

Finney County

Location X

Rig up

Drilling and Remarks:

RECORD

Cased in., ft.

Sand

Gas

Oil

Total Depth

PRODUCTION

1st 24 hrs. Nat.

1st 24 hrs. after shot

Gas Cu. Ft.

Dry Hole

Abandoned

Date

MAY 29 1946 19

S. J. LEWIS Scout

KANSAS

Kansas Pool Name Hugoton Pool

Map No. _____ Sec. 35 Twp. 23 R. 33W

Well No. 1 Neiderklein

Stanolind Company

COMPLETED

Contractor

SW NE

E12894

SECTION PLAT

_____ Ft. from N. Line

50 Ft. from S. Line

_____ Ft. from E. Line

50 Ft. from W. Line

		6	

Finney County

Location _____

Rig up _____

Drilling and Remarks:

6" C2695
Perf.
20000 acid
1,420,000 Gas
385# R Pe

RECORD

Cased _____ in., _____ ft.

Sand _____

Gas _____

Oil _____

Total Depth 2715

PRODUCTION

1st 24 hrs. Nat. _____

1st 24 hrs. after shot _____

Gas _____ Cu. Ft.

Dry Hole _____

Abandoned _____

Date

SEP 1 8 1946 19

S. J. LEWIS Scout