


Section 35 Township 23 Range 34-W

Well No. #1 Garden City "M"

Company Cities Service

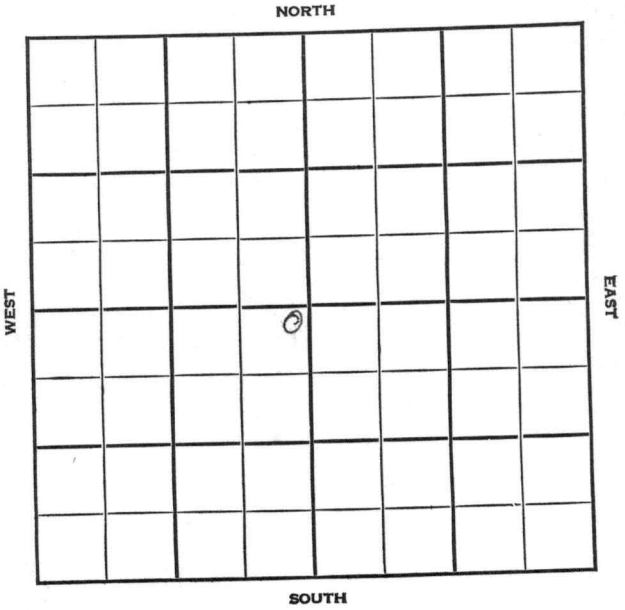



Sec. 35 Twp. 23 R. 34W

Well No. #1 Garden City "M" Farm

Cities Service Company

Hugoton Pool


100' Ft. from N. Line

_____ Ft. from S. Line

100' Ft. from E. Line

_____ Ft. from W. Line

NE SW

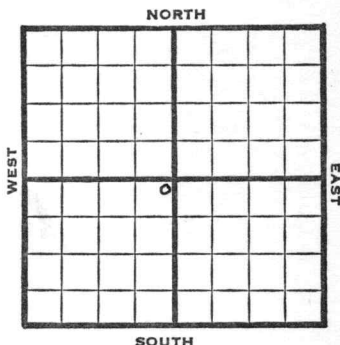

1948

Elev. 2955' REPORT

7/8
7/14

Location
8" @ 750'
Drlg 2140'

7/21

TD 2657'
5" @ 2656'

7/28

30 shots 2642-48'
40 shots 2624-32'
40 shots 2608-16'
90 shots 2560-74'
80 shots 2516-32'
80 shots 2494-2510- 30,000 acid

8/4

9000 acid.

8/11

5" @ 2656'
TD 2657'
Perf.
Acid 39,000
Gas 5,010,000
R. Pr. 420#

COMPLETED

Map No. _____ Sec. 35 Twp. 23 R. 34W

Well No. 1 Garden City "M"

Cities Service Company

FIRST REPORT

Contractor

NE SW

SECTION PLAT

100 Ft. from N. Line

_____ Ft. from S. Line

100 Ft. from E. Line

_____ Ft. from W. Line

Finney County

Location X

Rig up _____

Drilling and Remarks:

RECORD

Cased _____ in., _____ ft.

Sand _____

Gas _____

Oil _____

Total Depth _____

PRODUCTION

1st 24 hrs. Nat. _____

1st 24 hrs. after shot _____

Gas _____ Cu. Ft.

Dry Hole _____

Abandoned _____

Date

JUL 8 1948 19 _____ S. J. LEWIS Scout

Finney County Kansas StateMap No. _____ Sec. 35 Twp. 23 R. 34NWell No. 1 Garden City "M"Cities Service Company**COMPLETE**

Contractor

NE SW

E. 2955**SECTION PLAT**

100 Ft. from N. Line Ft. from S. Line100 Ft. from E. Line Ft. from W. LineHugoton Pool

Remarks:

5" @ 26564" @ 2657Perf.290000 acid5, 010, 000 gal420 # R/P

Date

AUG 11 1948

Scout

S. J. LEWIS