

KANSAS


Kearny

FORM 51 IOM 12-46 PETROL

Section 35 Township 23 Range 35W

Well No. 1 Beckett

Company Cities Service

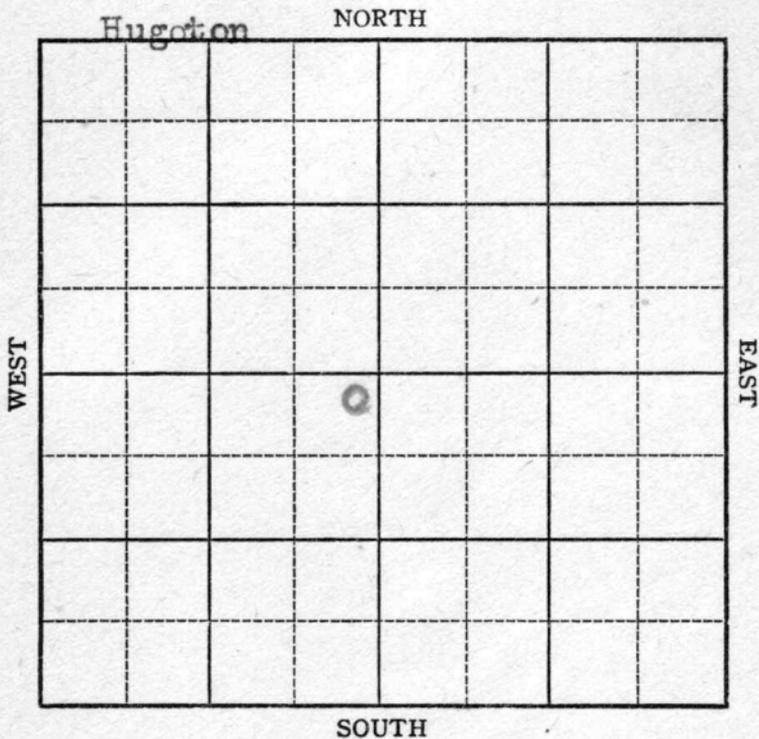

KANSAS

Kearny

Sec. 35 Twp. 23 R. 35W

Well No. #1 Beckett Farm

Cities Service Company

Hugoton


100 Ft. from N. Line

         Ft. from S. Line

100 Ft. from E. Line

         Ft. from W. Line

NE SW

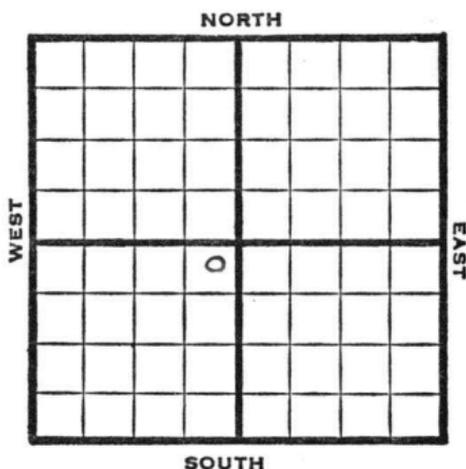

1947 Elev. 3002' REPORT

8/6	Location	
8/13	"	
8/20	8" @ 800'	
	WOC	
8/27	TD 2690'	Run 5"
9/3	"	
9/10	150 shots	2612-42
	180 shots	2500-86
	90 shots	2560-78
	2200 Acid	
9/17	"	"
9/24	"	"
10/1	"	"
10/8	"	"
10/15	5" @ 2689	
	Perf 22,000 acid	
	3,880,000 Gas	
	TD 2690	
	428# RPr.	

COMPLETED

Kansas

Hugoton

Map No. \_\_\_\_\_ Sec. 35 \_\_\_\_\_ Twp. 23 \_\_\_\_\_ R. 35W \_\_\_\_\_

Well No. 1 Beckett

\_\_\_\_\_ Cities Service \_\_\_\_\_ Company

## FIRST REPORT

\_\_\_\_\_ Contractor

NE SW

## SECTION PLAT

100 Ft. from N. Line

\_\_\_\_\_ Ft. from S. Line

100 Ft. from E. Line

\_\_\_\_\_ Ft. from W. Line

	o		

Kearny CountyLocation X

Rig up \_\_\_\_\_

Drilling and Remarks:

## RECORD

Cased \_\_\_\_\_ in., \_\_\_\_\_ ft.

Sand \_\_\_\_\_

Gas \_\_\_\_\_

Oil \_\_\_\_\_

Total Depth \_\_\_\_\_

## PRODUCTION

1st 24 hrs. Nat. \_\_\_\_\_

1st 24 hrs. after shot \_\_\_\_\_

Gas \_\_\_\_\_ Cu. Ft.

Dry Hole \_\_\_\_\_

Abandoned \_\_\_\_\_

Date

AUG 6 1947 19S. J. LEWIS Scout

Map No. D Sec. 35 Twp. 23 R. 35W

Well No. 1 Beckett

Cities Service Company

**COMPLETE** Contractor

NE SW


*E13002*  
**SECTION PLAT**

100 Ft. from N. Line

         Ft. from S. Line

100 Ft. from E. Line

         Ft. from W. Line

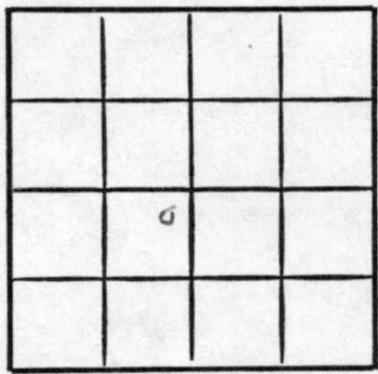

Kearny County

Location                                 

Rig up                                 

Drilling and Remarks:

*5" @ 2689*  
*Perf*  
*220000 cu ft*  
  
*3,880,000 Gas*  
  
*428# R/A*

**RECORD**

Cased          in.,          ft.  
 Sand                                   
 Gas                                   
 Oil                                   
 Total Depth 2680

**PRODUCTION**

1st 24 hrs. Nat.                                   
 1st 24 hrs. after shot                                   
 Gas                                  Cu. Ft.  
 Dry Hole                                   
 Abandoned                                 

Date

OCT 15 1947 19

S. J. LEWIS Scout