


Section 35 Township 23 Range 37W

Well No. #1 Longwood

Company E. M. Swearer

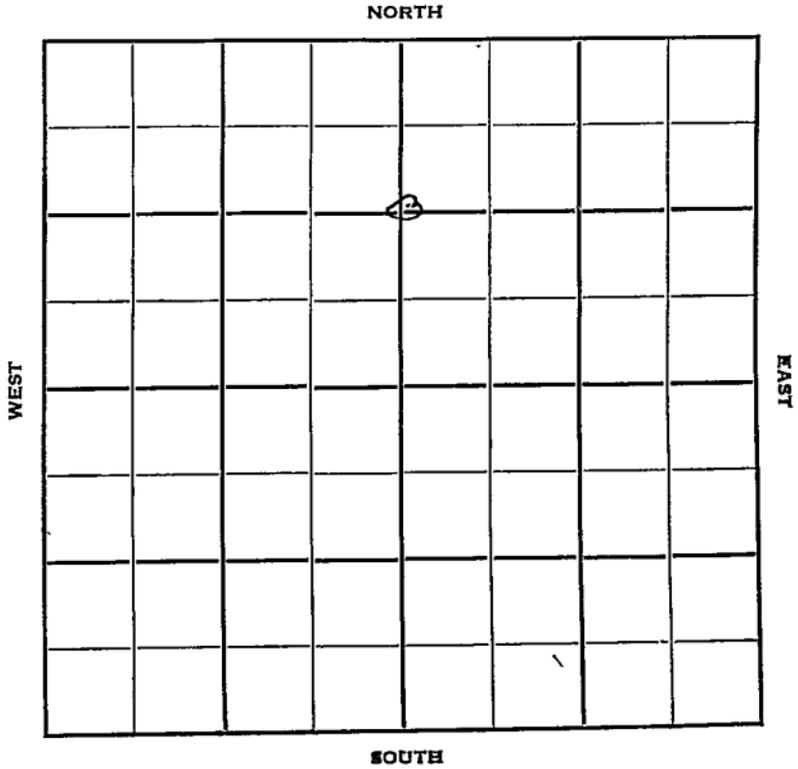



Sec. 35 Twp. 23 R. 37 W

Well No. # 1 Longwood Farm

E. M. Swearer Company

Contractor


1320 Ft. from N. Line

Ft. from S. Line

Ft. from E. Line

2640 Ft. from W. Line

C N/2 Sec.

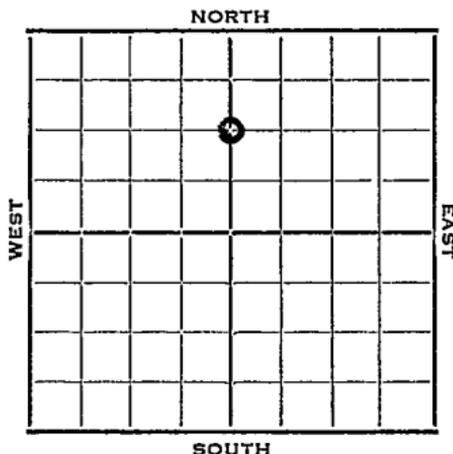

1952 Elev. 3265' REPORT


11/5 Spud 10-27-52
8" @ 480
Drlg. 2055'
11/12 TD 2567' 5" @ 2561'
11/20 DD @ 2615' Her 2562-90'

11/27 NR

12/3 Spud 10-27-52
Gas Well
TD ~~2615'~~ 2760' (corrected)
8" @ 480
Her. 2562
TD 2567
5" @ 2561
DD 2615
Comp. 2,520,000 gas

1953
1/14 **COMPLETED**
ADDITIONAL INFORMATION & CORRECTED DOPE
Completed 12-3-52
Corrected dope. TD 2760'
Her 2560' Kri. 2572' Win. 2610'
Ft. Riley 2663' L. Ft. Riley 2706'
15,000 A

COMPLETED

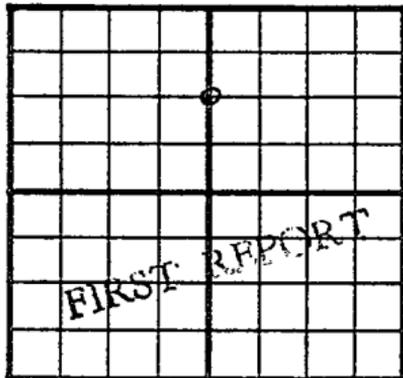County Kearny State KansasSec. 35 (Blk. Twp.) 23 (Sur. Rge.) 37W Map No.Operator E. M. SwearerWell No. 1 Farm LongwoodElev. _____ Location C N $\frac{1}{2}$ Sec.1320Ft. From N Line Sec.2640Ft. From W Line Quarter1st. Report NOV 5 1952

Completion _____

Remarks _____

Spudding Date 10-27-52

Drlg. Data

8" @ 480 drlg. 2055

J. G. McGEHEE


County Kearny State Kansas

Sec. 35 (Blk. 23 (Sur. 37W Map No. Twp. Rge.)

Operator E. M. Swearer

Well No. 1 Farm Longwood

Elev. 3265 Location C N $\frac{1}{2}$ Sec.

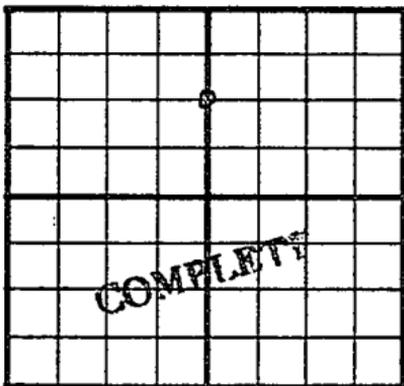

132 Ft. From N Line Sec.

264 Ft. From W Line Quarter

1st. Report

Completion DEC 3 1952

Remarks

Spudding Date 10-27-52

Drlg. Data Gas well TD 2615

8" @ 480 Her. 2562 TD 2567 5" @ 2561

DD 2615 Comp. 2,520,000 gas

Map No. _____ Sec. 35 Twp. 23 R. 37W


Well No. 1 Longwood

Ed Swearer Company

Contractor

C $N\frac{1}{2}$ Sec.

SECTION PLAT

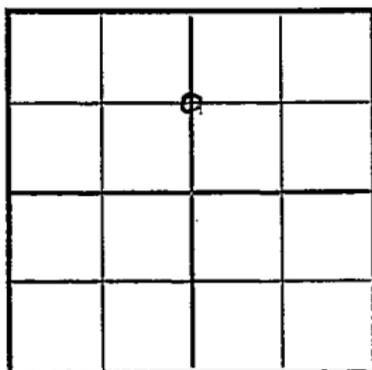

1320 Ft. from N. Line

_____ Ft. from S. Line

_____ Ft. from E. Line

2640 Ft. from W. Line

Kearny County

RECORD

Location _____

Cased _____ in., _____ ft.

Rig up _____

Sand _____

Drilling and Remarks:

Gas _____

Completed 12-3-52

Oil _____

Corrected dope

Total Depth _____

TD 2760

Her. 2560

Kri. 2572

Win. 2610

Ft. Riley 2663

L. Ft. Riley 2706

15000 A

PRODUCTION

1st 24 hrs. Nat. _____

1st 24 hrs. after shot _____

Gas _____ Cu. Ft.

Dry Hole _____

Abandoned _____

Date _____

JAN 14 1952

J. G. McGEHEE Scout