


Section 35 Township 23 Range 38W

Well No. #1 Rohlman Gas Unit

Company Stanolind

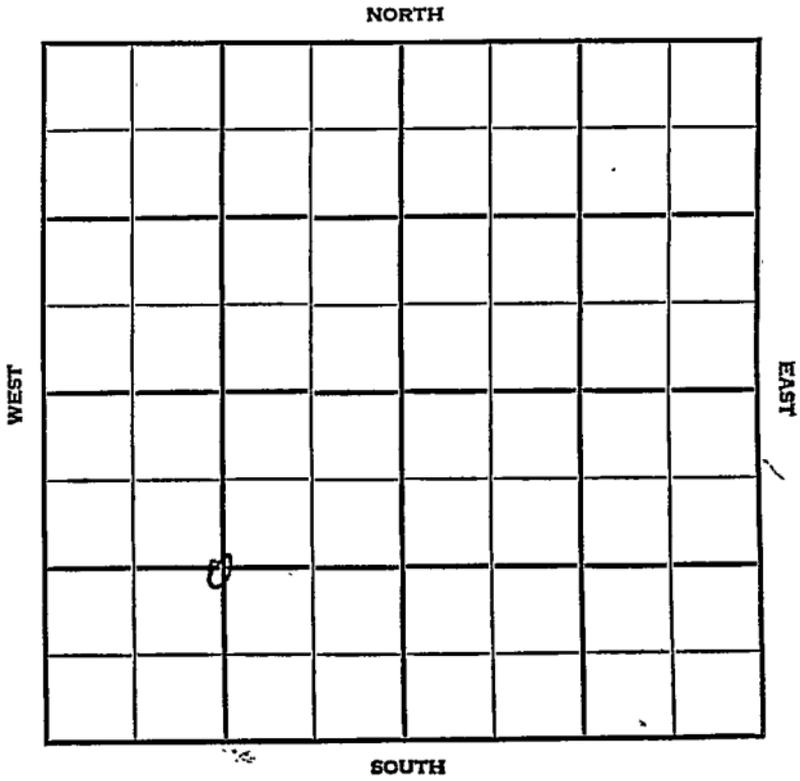

Kearny

KAN 15

SEC.	TWP.	R.
35	23	38W


WELL NO. #1 Rohlman Gas Unit FARM

COMPANY Stanolind

CONTRACTOR Barbour

Hugoton Pool

_____ Ft. from N. Line
 1320 _____ Ft. from S. Line
 _____ Ft. from E. Line
 1320 _____ Ft. from W. Line
 C SW/4

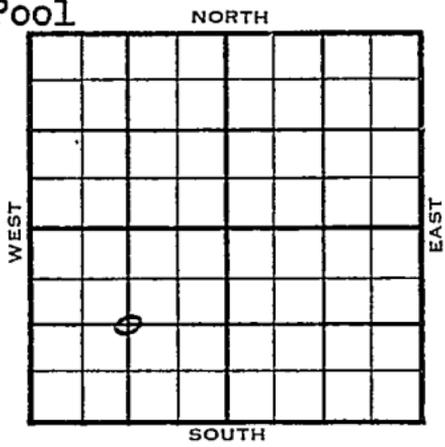

	ELEVATION	REPORT
1954	3339'	

11/11
 1955
 1/5

Location
 Gas Well - TD 2800'
 Her. 2600', Win. 2653', Tow. 2718',
 Ft. Riley 2757'
 TD 2800'
 5" @ 2780'
 CO to 2770'
 24/2758-62', 42/2748-55, 42/2731-38,
 4000A
 735,000 cfg, 144 gwph
 SP 2722'
 52/2660-69, 42/2675-82, 78/2698-2709,
 A-frac
 4500A
 1,008,000 cfg
 PB 2651
 54/2611-20, 60/2636-46, 635,000 cfgpd
 4 gwph
 A-frac
 300,000 cfg, 30 gwph
 CO to 2713, 638,000 cfg 25 gwph
 Comp. 2,041,000 cfgpd 325#

COMPLETED


County Kearny State Kansas

Sec. 35 (Blk.) 23 (Sur. Rge.) 38W Map No.

Operator Stanolind

Well No. 1 Farm Rohlman Gas Unit

Elev. 3339 Location C SW/4

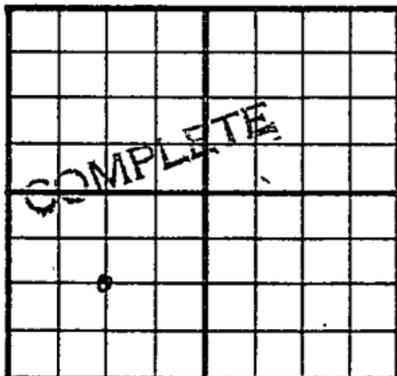

1320Ft. From S Line SW

1320Ft. From W Line Quarter

Ist. Report

JAN 5 1955

Completion

Remarks Hugoton Pool

Barbour - Contr.

Spudding Date

Drlg. Data Gas well TD 2800

Her. 2600 Win. 2653 Tow. 2718

Ft. Riley 2757 TD 2800 5" @ 2780

C0 to 2770 24/ 2758-62 42/ 2748-55

42/ 2731-38 4000 A 735,000 cfg

144 gwph SP 2722 54/ 2660-69

42/ 2675-82 78/ 2698-2709 A-frac

4500 A 1,008,000 cfg PB 2651

54/ 2611-20 60/ 2636-46 635,000 cfgpd

4 gwph A-frac 300,000 cfg 30 gwph

C0 to 2713 638,000 cfg 25 gwph

Comp. 2,041,000 cfgpd 325#