


Rend

Map No. KANSAS Sec. 36 Twp. 23 R. 40
 Well No. 1 Stucky Farm
Texas Co. Company

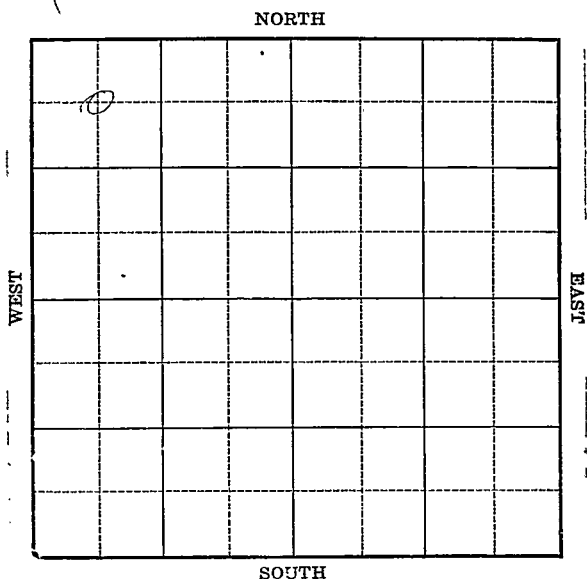

Location _____

Drilling Remarks _____

Rig Up _____

Drilling Remarks _____

RECORD

Cased _____ in. _____ ft.

Sand _____

Gas _____

Oil _____

Total Depth _____

PRODUCTION

1st 24 hrs. Nat. _____

1st 24 hrs. after shot _____

Gas _____ cu. ft.

Dry Hole _____

Abandoned _____

Rend

Map No. KANSAS Sec. 36 Twp. 23 R. 4 10

Well No. 1 Stucky Farm


Texas Co Company

660' Ft. from N. Line

_____ Ft. from S. Line

_____ Ft. from E. Line

660' Ft. from W. Line

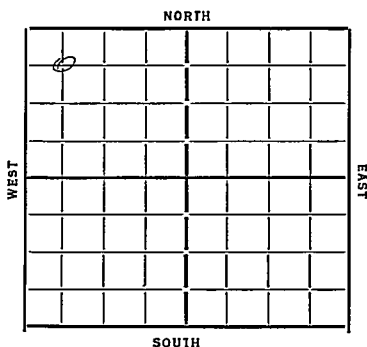

Date 1953

REPORT

11/22 Moving in rig
11/29 Rigging Rotary
12/6 Coreg 1472 12" at 480
12/13 2117 T.D. P.B. 1646'
12/27 Coreg 2285?
1/4 " 2930
1/11 Chat 3253 8" at 3257
T.D. 3260. C.O.
1/17 RWST.
1/24 8" collapsed.
1/31 6" 3257 4 Chat 3280 corrected
T.D. 3288 Rep. Engine
2/7 TD 3360 flow 205 Bbls 24 hrs.
2/14 Chat 3280 TD 3365 80 Bbls flow

COMPLETED

Map No. 40 Sec. 36 Twp 23 R. 4W
 Well No. 1 - Turkey
Texas Co Company

Contractor

FIRST REPORTS

660 Ft. from N. Line

..... Ft. from S. Line

..... Ft. from E. Line

660 Ft. from W. Line

SECTION PLAT

0			

Location.....

Rig up.....

Drilling and Remarks:

Moving in

RECORD

Cased.....in.,ft.

Sand.....

Gas.....

Oil.....

Total Depth.....

PRODUCTION

1st 24 hrs. Nat.....

1st 24 hrs. after shot.....

Gas.....Cu. Ft.

Dry Hole.....

Abandoned.....

Date

11-27-33 O. Mannschreck 192 Scott

Map No. 40 Sec. 36 Twp. 23 R. 4WWell No. 1- StuckyTexas Co Company

Contractor

COMPLETED

SECTION PLAT

0			

660 Ft. from N. Line

Ft. from S. Line

Ft. from E. Line

660 Ft. from W. Line

RECORD

Location

Cased in. ft.Sand Chat 3280

Gas

Oil

Total Depth 3365

PRODUCTION

1st 24 hrs. Nat.

1st 24 hrs. after shot

Gas Cu. Ft.

Dry Hole

Abandoned

Drilling and Remarks:

803 fms
flow

Date

2-14-34 192 O. Munnich Scout