


Reus

Form 51-5M-11-31-Palace

Map No. KANSAS Sec. 36 Twp. 23 R. 4 W

Well No. 2 Stucky Farm
Jays Col. Company

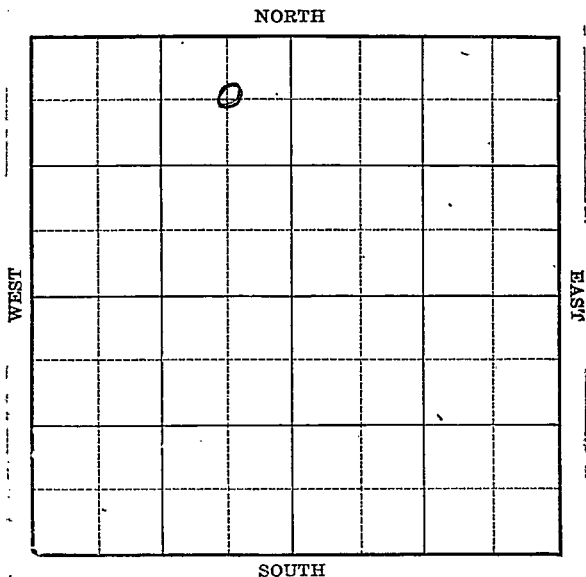

Location _____

Drilling Remarks _____

RECORD

Cased _____ in _____ ft.

Sand _____

Gas _____

Oil _____

Total Depth _____

Rig Up _____

Drilling Remarks _____

PRODUCTION

1st 24 hrs. Nat. _____

1st 24 hrs. after shot _____

Gas _____ cu. ft.

Dry Hole _____

Abandoned _____

Reno

Map No. _____ Sec. 36 Twp 23 R. 4W


Well No. 7 Stucky Farm
Jones Co. Company

660 Ft. from N. Line

_____ Ft. from S. Line

660 Ft. from E. Line

_____ Ft. from W. Line

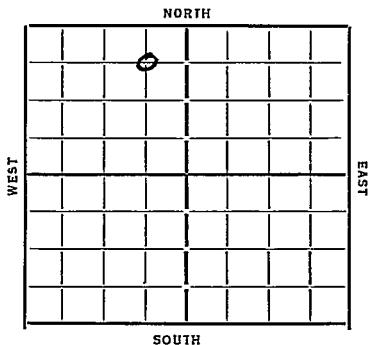

Date 1924

REPORT

<u>5/9</u>	<u>Rog</u>		
<u>5/18</u>	<u>—</u>		
<u>5/25</u>	<u>Dlg 1158</u>	<u>12 1/2</u>	<u>479</u>
<u>5/31</u>	<u>" 2579</u>		
<u>6/7</u>	<u>Rog 3156</u>		
<u>6/14</u>	<u>—</u>		
<u>6/21</u>	<u>Dlg 3181</u>		
<u>6/28</u>	<u>TD 3299</u>	<u>8"</u>	<u>3393</u> <u>rust</u>
<u>7/5</u>	<u>—</u>		
<u>7/12</u>	<u>TC 3266</u>	<u>A.O.</u>	<u>3324</u>
	<u>Pay 3360</u>	<u>-65</u>	<u>1200</u> <u>oil</u> <u>4 hrs.</u>
<u>7/19</u>	<u>TD 3370</u>	<u>road</u>	<u>70</u> <u>Bbls</u>
	<u>24 hrs</u>	<u>acidizing</u>	
<u>7/25</u>	<u>Chat 3266</u>	<u>TD 3370</u>	
	<u>87</u>	<u>oil</u>	<u>30</u> <u>water</u>

COMPLETED

Map No. 40 Sec. 36 Twp. 23 R. 4W

Well No. 2 - Stucky
Texas Co Company

Contractor

FIRST REPORTS

SECTION PLAT

660 Ft. from N. Line

_____ Ft. from S. Line

660 Ft. from E. Line

_____ Ft. from W. Line

	o		

Location _____

Rig up _____

Drilling and Remarks:

Log

RECORD

Cased _____ in., _____ ft.

Sand _____

Gas _____

Oil _____

Total Depth _____

PRODUCTION

1st 24 hrs. Nat. _____

1st 24 hrs. after shot _____

Gas _____ Cu. Ft.

Dry Hole _____

Abandoned _____

Date

5-9-37 19

ORVAL MANNSCHRECK

Scout

Map No. 40 Sec. 36 Twp. 23 R. 4W

Well No. 2-Stubky
Texas Co Company

Contractor

COMPLETED

SECTION PLAT

	0		

660 Ft. from N. Line

_____ Ft. from S. Line

660 Ft. from E. Line

_____ Ft. from W. Line

Location _____

Rig up _____

Drilling and Remarks:

87 oil
30 water

RECORD

Cased _____ in., _____ ft.

Sand Chat 3266

Gas _____

Oil _____

Total Depth 3370

PRODUCTION

1st 24 hrs. Nat. _____

1st 24 hrs. after shot _____

Gas _____ Cu. Ft.

Dry Hole _____

Abandoned _____

Date

7-25-34 19

ORVAL MANNING Scout