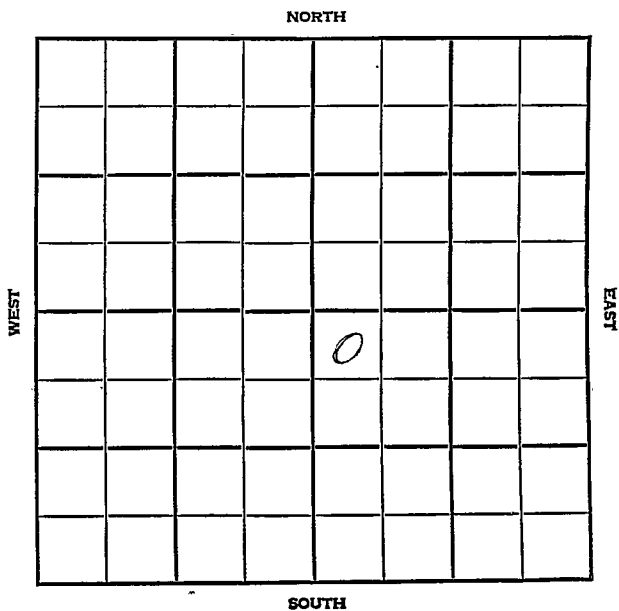


Section 36 Township 23 Range 5WWell No. #1 ~~Aiken~~ BaconCompany Brunson Prod.

County Reno Elev. _____
 Sec. 36 Twp. 23 Rge. 5W
 Company Brunson Prod.
 Farm Name Aiken No. 1

TOPS	DEPTH	LOG	DATUM	Loc. in Sec.
Anb.				NW NW SE
Tr.				
H.				
Tr.				
Dg.				
BL.				
L.				Geol.
K.C.				Contr.
B.K.C.				
Ce.				
C.				
M.				Pool
M.				
K.				
Mz.				
Mo.				
V.				
S.				
S.				
A.				
R.				
Pe.				
G.				
T.D.				

FIRST REPORT

OCT 31 '56

Date Comm.
 M I R

[Handwritten signature and date: 10-31-56]

County Rand Elev. 1493
 Sec. 36 Twp. 23 Rge. 5W
 Company Brunson Prod.
 Farm Name Aiken Bacon No. 1

TOPS	DEPTH	LOG	DATUM	Loc. in Sec.
Anb.				NW NW SE
Tr.				
Dg.				
BL.				
L.				
K.C.				Geol.
B.K.C.				Contr.
Ce.				
C.				
M. <u>BP 29</u>	<u>3369</u>			
M. <u>LI</u>	<u>3375</u>			Pool
K. <u>M. chert</u>	<u>3407</u>			
Mz.				
Me.				
V.				
S.				
S.				
A.				
R.				
Pe.				
G.				
TD.	<u>3440</u>			

ABANDONED

0

NOV 15 '56

Date Comm.

M I R NOV 7 '56 11-2-56 85/8 180

1200 @ 1700 NOV 13 '56

cnd 3380-3406 Full rec

NEA