


Map No. KANSAS Sec. 36 Twp. 23 R. 5^w

Well No. 1 ~~5~~ BACON Farm
W.C. Mc Bride Drill Company

NORTH

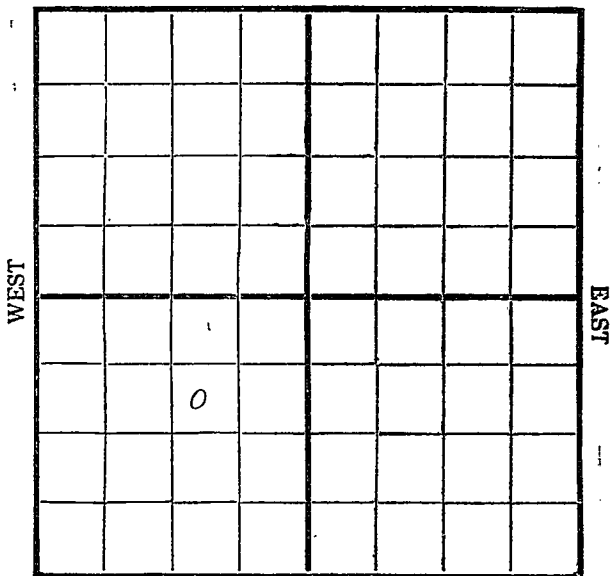

SOUTH

Location _____
Drilling Remarks _____

Rig Up _____
Drilling Remarks _____

RECORD

Cased _____ in. _____ ft.
Sand _____
Gas _____
Oil _____
Total Depth _____

PRODUCTION


1st 24 hrs. Nat. _____
1st 24 hrs. after shot _____
Gas _____ cu. ft. _____
Dry Hole _____
Abandoned _____

Reno

Map No. KANSAS Sec. 36 Twp. 23 R. 5^w

Well No. 1 - ~~Bacon~~ Bacon Farm
W. C. Mc Bride Oil Co. Company

990 Ft. from N. Line
 _____ Ft. from S. Line
990 Ft. from E. Line
 _____ Ft. from W. Line

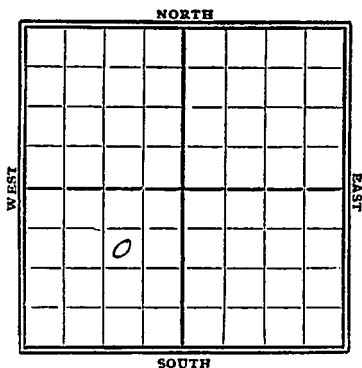

1929

Date REPORT

Date	REPORT
11/20	Location
11/27	—
12/4	—
12/11	Roce
12/18	—
12/23	—
12/30	—
1930	
1/8	—
1/15	—
1/22	—
1/29	—
2/5	—
2/12	—
2/19	Rigging up.
2/26	Shut
3/5	S. D. 458'
3/12	Orlg. 925'
3/19	" 1650'
3/26	" 2370'
4/2	" 2530'
4/9	" 2660'

- 4/16 - Hrlg 2740
 4/23 - 2945 - Hrlg
 4/30 - Hrlg. 3070'
 5/7 - " 3160'
 5/14 - 3295 rebuild rig
 5/21 - _____
 5/28 - Rign up
 6/4 - U.R. 8" - 3355'
 6/11 - Ghat 3380'
 T.D. 3386 - U/R. 8"
 6/18 - Hrlg. 3460'
 2 bbls oil 5 bbls
 water per hour.
 3410-18 Ghat,
 H7W 3420-50'
 6/25 - Hrlg. 3607'
 Base Miss. 3580'
 7/2 - Hrlg. 3707'
 7/9 - Viola 3812-17
 2 1/4 bbls oil per hr.
 7/16 - Wilcox 3843'
 H7W T.D. 3913'
 run 5"
 7/23 - Alc lime 3918 HFW
 T.D. 3934
 Dry & Abandon

Map No. KANSAS Sec. 26 Twp. 23 R. 5W

Well No. 1 Community

H. C. McBride & Co. Company

Contractor

SECTION PLAT

	0		

990 Ft. from N. Line

..... Ft. from S. Line

990 Ft. from E. Line

..... Ft. from W. Line

FIRST REPORTS

Location

Rig up

Drilling and Remarks:

RECORD

Cased..... in., ft.

Sand.....

Gas.....

Oil.....

Total Depth.....

PRODUCTION

1st 24 hrs. Nat.....

1st 24 hrs. after shot.....

Gas..... Cu. Ft.

Dry Hole.....

Abandoned.....

Date

NOV 20 1929

S J. LEWIS

Scout

Map No. **KANSAS** Sec. 36 Twp. 23 R. 5W

Well No. 10 1 Bacon

H. C. McBride & Co. Company

Contractor

SECTION PLAT

990 Ft. from N. Line

..... Ft. from S. Line

990 Ft. from E. Line

..... Ft. from W. Line

CC SECTION

Location.....

Rig up.....

Drilling and Remarks:

*Revised
#1 Community*

RECORD

Cased..... in., ft.

Sand.....

Gas.....

Oil.....

Total Depth.....

PRODUCTION

1st 24 hrs. Nat.....

1st 24 hrs. after shot.....

Gas..... Cu. Ft.

Dry Hole.....

Abandoned.....

Date

FEB 19 1920

S. J. LEWIS

Scout

Map No. KANSAS Sec. 36 Twp. 23 R. 5W

Well No. 1 Bacon

W.C.M. Bride & Co. Company

Contractor

SECTION PLAT

990 Ft. from N. Line

_____ Ft. from S. Line

990 Ft. from E. Line

_____ Ft. from W. Line

	0		

ABANDONED

Location _____

Rig up _____

Drilling and Remarks:

Selected 3918
NFW

RECORD

Cased _____ in., _____ ft.

Sand _____

Gas _____

Oil _____

Total Depth 3904

PRODUCTION

1st 24 hrs. Nat. _____

1st 24 hrs. after shot _____

Gas _____ Cu. Ft.

Dry Hole _____

Abandoned _____

Date

EOL * 1839

S. J. LEWIS Scout