


Section 36 Township 23 Range 10W

Well No. 1 Taylor

Company Schermerhorn Oil

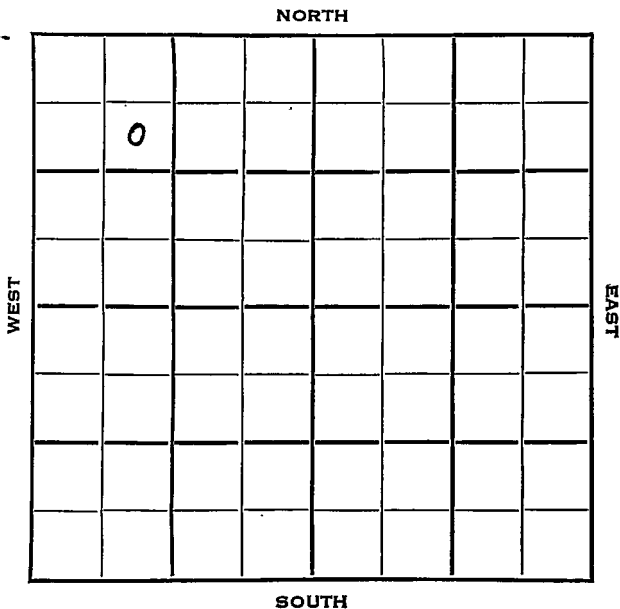

Reno

KANSAS

SEC.	TWP.	R.
36	23	10W

WELL NO. _____

1 Taylor _____ FARM

COMPANY

Schermerhorn Oil _____

CONTRACTOR

Wildcat


990 _____ Ft. from N. Line

_____ Ft. from S. Line

_____ Ft. from E. Line

990 _____ Ft. from W. Line

SE NW NW

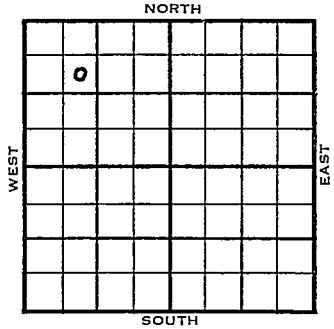

	ELEVATION	REPORT
1953	1750'	

9/16 DST 3826-46, opn 1 hr., rec. 475' wtr..
Drlg. 3890'

9/23 D & A TD 4014' Heeb 3081 Br lime
3252' Lans 3284 Miss 3630
Kh. 3680 Viola 3819
DST 3826-46 open 1 hr rec 475' wtr.
Simp. 3922 Arb. 3999'
TD 4014' D & A

ABANDONED

