

KANSAS


FORM 51 5M PETROL

Stafford

Section 36 Township 23 Range 11-W


Well No. #2 Krey

Company Transwestern

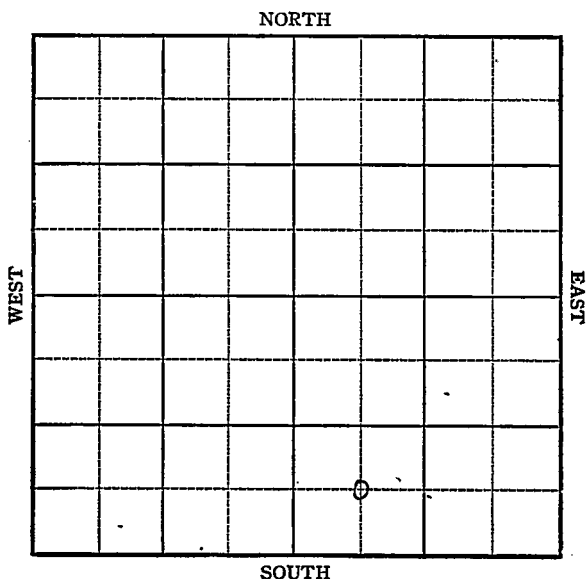

Sec. 36 Twp. 23 R. 11-WWell No. #2 Krey FarmTranswestern Company

NORTH

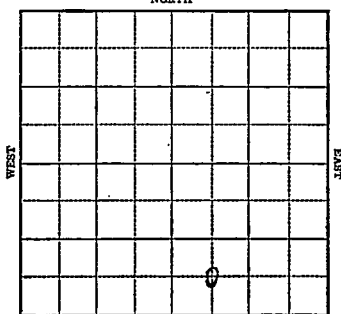

SOUTH

 Ft. from N. Line660 Ft. from S. Line Ft. from E. Line660 Ft. from W. LineElev. 1803

1943

R E P O R T

9/22 Location

9/29 9" @ 332
Drlg. 15350'

10/6 Drlg. 3250'

10/13 Misener 3683

Viola 3701

T.D. 3708

5" @ 3703

Rust

10/20 T.D. 3737-2600' oil in 3 hrs.

10/27 Viola 3701

5" @ 3703

2000 acid

Flow 464 oil & 15% water Pot.

T.D. 3737

Gravity 42

COMPLETED

KANSASMap No. 7 Sec. 36 Twp. 23 R. 11THWell No. 2 KreyTranswestern

Company

FIRST REPORT

Contractor

C SW SE Ft. from N. Line660 Ft. from S. Line Ft. from E. Line660 Ft. from W. Line**SECTION PLAT**

		o	

Peace Creek PoolLocation XRig up

Drilling and Remarks:

RECORDCased in., ft.Sand Gas Oil Total Depth **PRODUCTION**1st 24 hrs. Nat. 1st 24 hrs. after shot Gas Cu. Ft.Dry Hole Abandoned

Date

SEP 22 194319S. J. LEWISScout

KANSASMap No. 77 Sec. 36 Twp. 23 R. 11WWell No. 2 KreyTranswestern


Company

COMPLETED

Contractor

C SW SE

SECTION PLAT

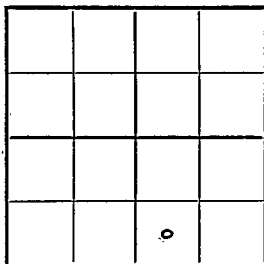

Ft. from N. Line

660

Ft. from S. Line

Ft. from E. Line

660

Ft. from W. Line

Zenith Pool

Location

Rig up

Drilling and Remarks:

Violet 37015" @ 370.32000 acidFlow 46 48 oil+15% Water42 @ 37

RECORD

Cased _____ in., _____ ft.

Sand _____

Gas _____

Oil _____

Total Depth 3737

PRODUCTION

1st 24 hrs. Nat. _____

1st 24 hrs. after shot _____

Gas _____ Cu. Ft.

Dry Hole _____

Abandoned _____

Date

OCT 27 194319S. J. LEWIS

Scout