

STafford

Section 36 Township 23 Range 11W

Well No. #2 Smart

Company Derby & D.R.M. Drilg.

|  |  |  |  |  |   |  |  |
|--|--|--|--|--|---|--|--|
|  |  |  |  |  | 0 |  |  |
|  |  |  |  |  |   |  |  |
|  |  |  |  |  |   |  |  |
2

**KANSAS**

Stafford

Sec. 36 Twp. 23 R. 11W

Well No. #2 Smart Farm

Derby & D.R.M. Drlg. Company

zenith


NORTH

330 Ft. from N. Line

Ft. from S. Line

Ft. from E. Line

990 Ft. from W. Line

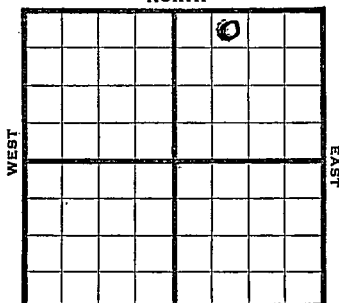

SOUTH

*elev. 1802*

1944

R E P O R T

4/26  
5/3

Location  
"

5/10

8" @ 244  
Drlg. 275'

5/17

Drlg. 2780

5/24

Lans 3306  
Misener 3555  
Viola 3674 SO  
TD 3700 Run Csg.

5/31

Misener 3552  
Viola 3671  
5" @ ~~3694~~ *3697 3694*  
TD 3700 corrected  
RUST

6/10

Viola 3671  
5" - ~~3697~~ *3694*  
Still fishing bailer  
No shows reported (Tel)

6/13

Show oil 3710  
Drilled to Total Depth 3733  
No. shows below 3710  
Will acidize with 2000 gallons (Tel)

6/15

TD 3733  
Show Oil 3710  
500 acid swab 1/4 oil and 1 water in  
2 1/2 hrs.  
**OVER**

1944

6/20 Top Viola 3671

5" - 3694 Total Depth 3711

2500 acid

Swab  $2\frac{1}{2}$  bbls fluid per hour for 2 hours

75% water

25% oil

Shut down for 12 hours

Swab  $1\frac{1}{2}$  bbls oil and

4- $\frac{3}{4}$ " bbls water - no time given

Swabbed  $5\frac{1}{4}$  bbls oil and

15 bbls water in 15 hours

Will go back up hole and test Misener  
sand (Tel)

6/21 2000 acid 600# Pr.

Shut down 12 hrs. 240' fluid.

Swab  $1\frac{1}{2}$  oil & 4- $\frac{3}{4}$  water.

Swab down. Swab  $5\frac{1}{2}$  oil plus 15 water  
in 5 hrs.

6/28 5" @ 3694

Viola 3671

TD 3733

Water

**ABANDONED**

**KANSAS**Pool Name ZenithMap No. 47 Sec. 36 Twp. 23 R. 11WWell No. 2 SmartDerby & D.R.M. Drlg. Company**FIRST REPORT**

Contractor

NE NW NE**SECTION PLAT**330 Ft. from N. Line       Ft. from S. Line       Ft. from E. Line990 Ft. from W. Line

|  |  |  |  |
|--|--|--|--|
|  |  |  |  |
|  |  |  |  |
|  |  |  |  |
|  |  |  |  |

Stafford CountyLocation XRig up       

Drilling and Remarks:

**RECORD**Cased        in.,        ft.Sand       Gas       Oil       Total Depth       **PRODUCTION**1st 24 hrs. Nat.       1st 24 hrs. after shot       Gas        Cu. Ft.Dry Hole       Abandoned       

Date

APR 26 1944 19S. J. LEWIS Scout

Pool Name Zenith  
 Map No. 47 Sec. 36 Twp. 23 R. 11W

Well No. 2 Smart

Derby & D.R.M. Drlg. Company

ABANDONED Contractor

NE NW NE


### SECTION PLAT

330 Ft. from N. Line

\_\_\_\_\_ Ft. from S. Line

\_\_\_\_\_ Ft. from E. Line

990 Ft. from W. Line

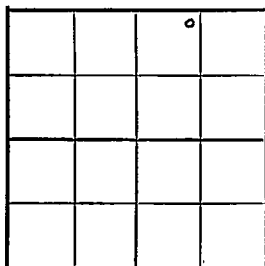

Stafford County

Location \_\_\_\_\_

Rig up \_\_\_\_\_

Drilling and Remarks:

*Viola 3671*

*5" C 3674*

*Water*

### RECORD

Cased \_\_\_\_\_ in., \_\_\_\_\_ ft.

Sand \_\_\_\_\_

Gas \_\_\_\_\_

Oil \_\_\_\_\_

Total Depth 1322

### PRODUCTION

1st 24 hrs. Nat. \_\_\_\_\_

1st 24 hrs. after shot \_\_\_\_\_

Gas \_\_\_\_\_ Cu. Ft.

Dry Hole \_\_\_\_\_

Abandoned \_\_\_\_\_

Date

JUN 28 1944 19

S. J. LEWIS Scout