

KANSAS


FORM 51 5M PETROL

Stafford

Section 36 Township 23 Range 11-~~W~~

Well No. #1 O. Volker

Company Republic Natural Gas

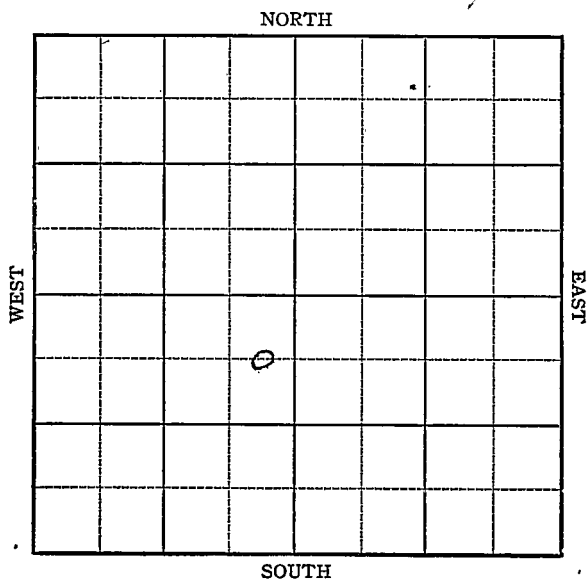


KANSAS

Stafford

Sec. 36 Twp. 23 R. 11-WWell No. #1 O. Volker FarmRepublic Natural Gas Company

NORTH

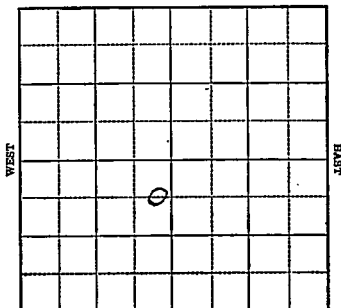

SOUTH

Ft. from N. Line

660 Ft. from S. Line330 Ft. from E. Line

Ft. from W. Line

Elev. 1807

1943

R E P O R T

11/24 Location.
12/1 10" @ 280'

Drlg. 705'

12/8 Drlg. 2700

12-15 Drlg. 3157'

12/22 Misener 3669

Viola 3688

7" @ 3698 TD

Rust

" "

12/29

1944

1-5

" "

1-12 TD 3721 flow 60 oil per hr.

1/19 " " " " " "

1/26 7" @ 3698

Viola 3690

TD 3721

Bonb Pot. 6405

Max. 3000

Gravity 42

COMPLETED

KANSAS 47 Sec. 36 Twp. 23 R. 11W
 Map No. _____

Well No. 1 O. Volker


Republic Natural Gas Company

COMPLETED

Contractor _____

C E L NE SW

SECTION PLAT

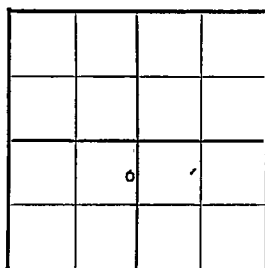

_____ Ft. from N. Line

660 Ft. from S. Line

330 Ft. from E. Line

_____ Ft. from W. Line

Zenith Pool

Location _____

Rig up _____

Drilling and Remarks:

Viola 3690

7" C 3698

Burn J. P. J.

6405

Max 3000

42° SW

RECORD

Cased _____ in., _____ ft.

Sand _____

Gas _____

Oil _____

Total Depth 3721

PRODUCTION

1st 24 hrs. Nat. _____

1st 24 hrs. after shot _____

Gas _____ Cu. Ft.

Dry Hole _____

Abandoned _____

Date _____

JAN 26 1944

19

S. J. LEWIS

Scout

Map No. TRANS 57 Sec. 36 Twp. 23 R. 11W


Well No. 10. Volker

Republic Natural Gas Company

FIRST REPORT Contractor

C E L NE SW

SECTION PLAT

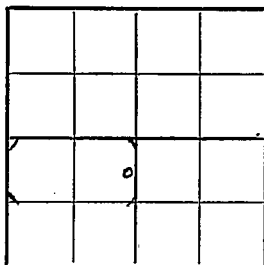

 Ft. from N. Line

660 Ft. from S. Line

330 Ft. from E. Line

 Ft. from W. Line

Zenith Pool

Location X

Rig up

Drilling and Remarks:

RECORD

Cased in., ft.

Sand

Gas

Oil

Total Depth

PRODUCTION

1st 24 hrs. Nat.

1st 24 hrs. after shot

Gas Cu. Ft.

Dry Hole

Abandoned

Date

NOV 24 1943 19 S. J. LEWIS Scout