


Section 36 Township 23 Range 11W

Well No. #1 Sturgeon

Company Eason Oil

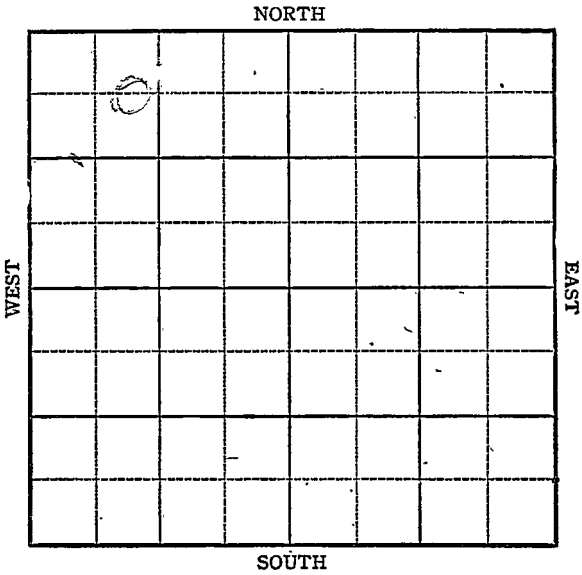

KANSAS

Stafford County

Sec. 36 Twp. 23 R. 11W

Well No. #1, Sturgeon Farm

Eason Oil Company

Zenith


660 Ft. from N. Line

Ft. from S. Line

Ft. from E. Line

990

Ft. from W. Line

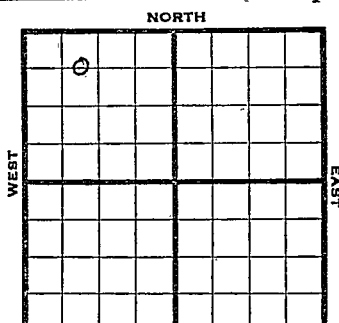

C E L NW NW Elev. 1801

1945

R E P O R T

1-10	Location
1/17	10" @ 309 WOC
1/26	Shut down
1/31	Drlg. 3286'
2/7	Viola 3677
	7" @ 3770 TD SO RUST
2/14	36 shots to 3700-10 500 acid
2/21	" " " " " "
2/28	" " " " " "
3/7	" " " " " "
3/14	" " " " " "
3/23	" " " " " "
3/29	2000 acid. Swab 2 oil PH
4/5	" " " " " "
4/12	" " " " " "
4/20	" " " " " "
4/27	" " " " " "
5/2	Viola 3677
	7" @ 3779
	TD 3779
	36 shots 3700-3710 2500 acid.
	Pump 211 oil plus 20% water Pot.
	Grav. 42.0

COMPLETED

Pool Name ZenithMap No. 47 Sec. 36 Twp. 23 R. 11WWell No. 1 SturgeonEason Oil

Company

FIRST REPORT

Contractor

CEL NW NW

SECTION PLAT

660 Ft. from N. Line Ft. from S. Line Ft. from E. Line990 Ft. from W. LineStaffordLocation XRig up

Drilling and Remarks:

*Shot 2 in
1 1/2 mi SW from
MC PC*

RECORD

Cased in. ft.Sand Gas Oil Total Depth

PRODUCTION

1st 24 hrs. Nat. 1st 24 hrs. after shot Gas Cu. Ft.Dry Hole Abandoned

Date

JAN 1 0 1945 19S. J. LEWIS

Scout

Kansas Pool Name ZenithMap No. 47 Sec. 36 Twp. 23 R. 11WWell No. 1 SturgeonEason Oil

Company

COMPLETED

Contractor

C E L NW NWE 1,180'
SECTION PLAT

<u>660</u>			

660 Ft. from N. Line Ft. from S. Line Ft. from E. Line990 Ft. from W. LineStafford CountyLocation Rig up

Drilling and Remarks:

Vista 36727" @ 377936 sh to 3700-102500 acidPump 2 1/2 oil + 20%Water 20%420 sh**RECORD .**Cased in., ft.Sand Gas Oil Total Depth 3778**PRODUCTION**1st 24 hrs. Nat. 1st 24 hrs. after shot Gas Cu. Ft.Dry Hole Abandoned

Date

MAY 2 1945 19S. J. LEWIS

Scout